


# RECORD SURVEY

LOCATED IN A PORTION OF THE E 1/2, SECTION 14,  
TOWNSHIP 5 NORTH, RANGE 28 EAST, W.M.  
UMATILLA COUNTY, OREGON

## SURVEYOR'S NARRATIVE

THE PURPOSE OF THIS SURVEY IS TO RE-SET THE BRASS CAP STREET MONUMENT NEAR THE INTERSECTION OF STATE HIGHWAY NO. 730 AND DRAPER ROAD. THIS MONUMENT WAS SET BY LANGLITZ IN HIS 1987 SURVEY FOR UMATILLA COUNTY DEPARTMENT OF PUBLIC WORKS (88-38-B). SAID MONUMENT WAS DESTROYED DURING RECENT CONSTRUCTION OF STATE HIGHWAY NO. 730. IN ADDITION THE PROPERTY CORNER AT THE SOUTHWEST CORNER OF THAT PROPERTY SURVEYED BY EDWARDS IN 1991 FOR THE PORT OF UMATILLA (91-55-A) WAS DISTURBED AND WE RE-SET IT. THE TWO SURVEYS ABOVE AND THE MONUMENTS SHOWN HERE AS FOUND WERE USED AS THE BASIS FOR RE-SETTING THE MONUMENTS.

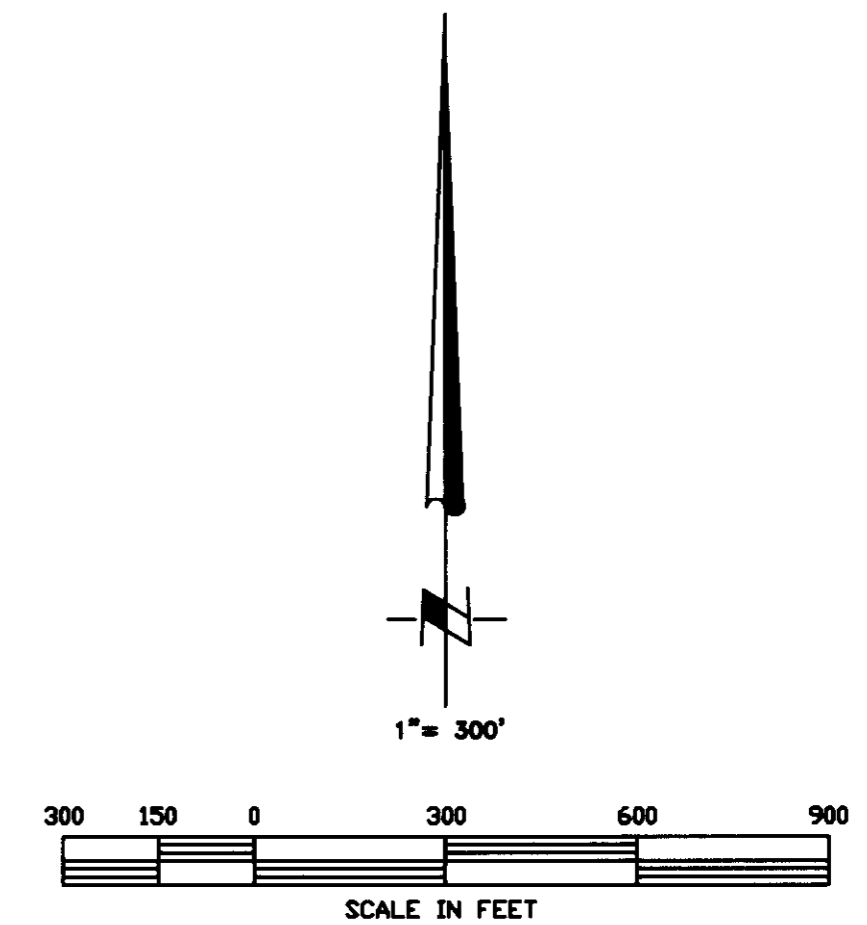

## SURVEYOR'S CERTIFICATION

I, JOHN A. BAALMAN, A PROFESSIONAL LAND SURVEYOR IN THE STATE OF OREGON HEREBY CERTIFY THAT THIS MAP CORRECTLY REPRESENTS A SURVEY CONDUCTED UNDER MY DIRECT SUPERVISION IN DECEMBER 1999, IN CONFORMANCE WITH THE REQUIREMENTS OF THE SURVEY RECORDING LAW, AS ESTABLISHED BY ORS 92.

REGISTERED  
PROFESSIONAL  
LAND SURVEYOR  
*John A. Baalman*  
OREGON  
JOHN A. BAALMAN  
02735LS  
EXPIRES 12-01

12/8/99  
DATE

## NOTES:

1. BASIS OF BEARING IS SURVEY NO. 88-38-B FOR UMATILLA COUNTY AND SURVEY NO. 91-55-A FOR PORT OF UMATILLA, RECORDS OF MORROW COUNTY, OREGON.
2. (M) = MEASURED (C) = COMPUTED (P) = PLAT (D) = DEED (R) = RECORD.
3. ⊙ = DENOTES 2-1/2" BRASS CAP HIGHWAY MONUMENT OR AS NOTED.
4. ○ = DENOTES SET 5/8"x24" REBAR WITH YELLOW PLASTIC CAP STAMPED 'RSI-JAB 02735LS'.
5. ● = DENOTES FOUND REBAR AS NOTED.
6. EQUIPMENT AND PROCEDURES USED: LIETZ SET 3 TOTAL STATION; CLOSED TRAVERSE AND RADIAL SURVEY METHODS UTILIZED.

REV: NONE

RECEIVED BY  
Umatilla County Surveyor  
Date 12-99  
Rec'd By KK  
No. 99-300-B

**RSA** ROGERS  
SURVEYING INC.  
205 SW THIRD STREET  
HERMISTON, OR. 97838  
PHONE (541) 567-5859  
FAX: (541) 567-6757

CLIENT	MORRILL ASPHALT	JOB NO.	OR08299
PROJECT	RECORD SURVEY SEC. 14, T.5N., R.28E.	F. B. NO.:	NONE
DRAWN BY:	RPJ	SCALE:	1" = 300'
APPROVED:	JAB	DATE:	12-08-99
		VERSION:	ACAD14
		FILE:	OR08299.DWG
		SHEET	1
		OF	1

