



Tax Lot 300, Williams  
Book 340, Page 313

**SURVEY FOR BOUNDARY ADJUSTMENT OF TAX LOTS IN SE1/4 OF NW1/4, SECTION 22 OF TOWNSHIP 6 NORTH, RANGE 34 EAST, OF THE WILLAMETTE MERIDIAN.**

**DESCRIPTION OF TAX LOT 1400 BEFORE BOUNDARY ADJSUTMENT**

Southeast Quarter of Northwest Quarter of Section 22, Township 6 North, Range 34 East of the Willamette Meridian, Umatilla County, Oregon;  
TOGETHER with easement for ingress and egress 40 feet in width, centerline of which is described as being 20 feet North of Southeast corner of North Half of Northwest Quarter of Section 22; thence West, parallel with South line of said North Half of Northwest Quarter, 40 feet to the true point of beginning for this centerline description; thence East, parallel with South line of Northwest Quarter and parallel with South line of North Half of Northeast Quarter of said Section 22 to a point on Westerly right of way line of County Road No. 536, and point of terminus; Subject to any and all water rights of way and roads.

ALSO SUBJECT TO:  
1. As disclosed by the tax rolls the premises herein described have been zoned or classified for farm use. At any time that said land is disqualified for such use said property will be subject to additional taxes and interest.  
2. Conditions contained in easements granted by Couse Creek Ranches, Inc., and Phillip Hoon to Helen Harris, for ingress and egress, recorded February 23, 1989, Microfilm R-176, Page 1646, Deed Records.

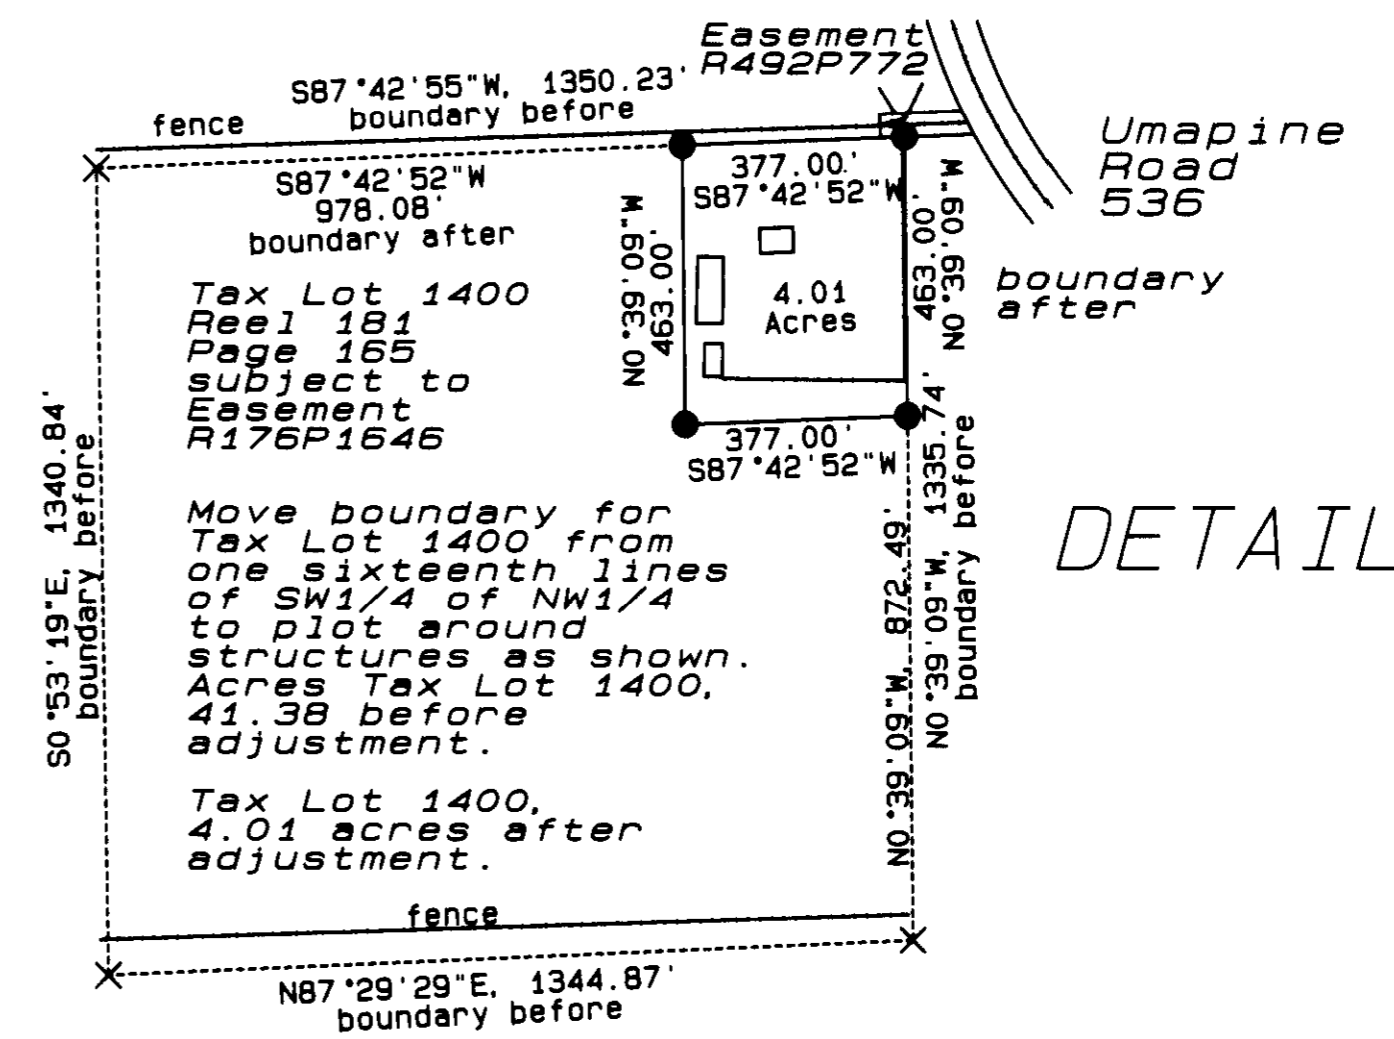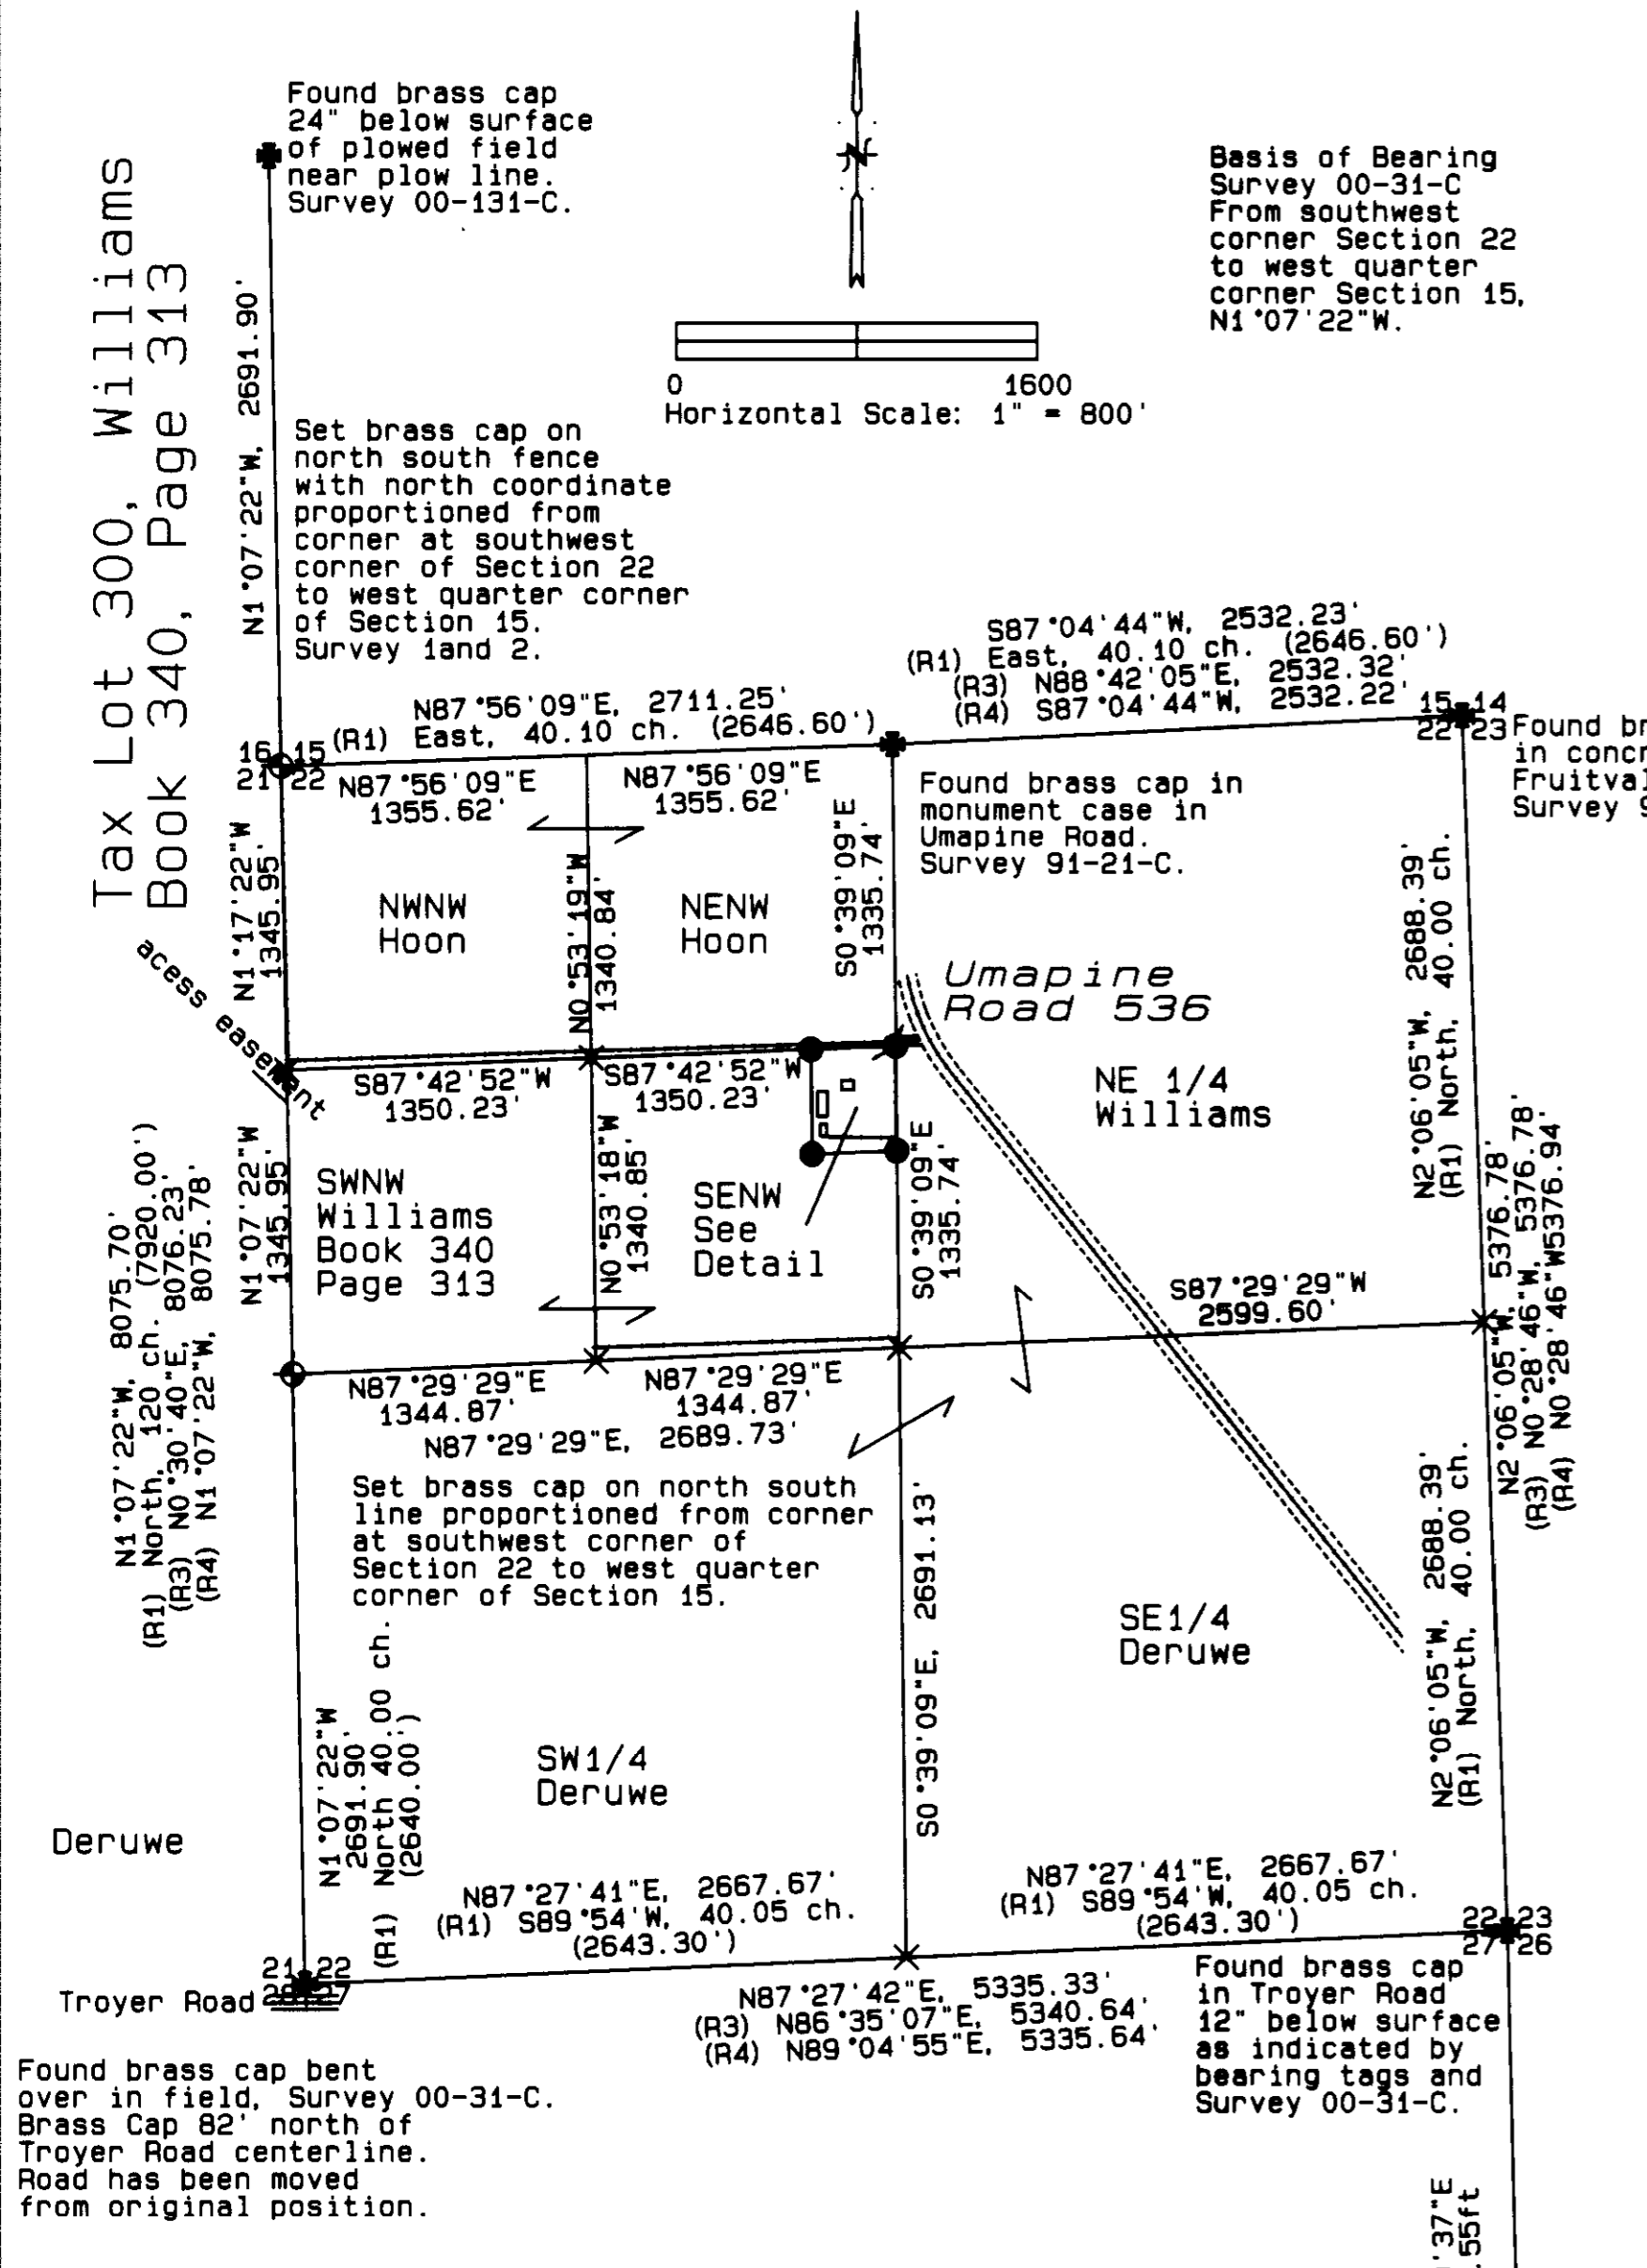

- RECORD SURVEYS**  
 R1. W. Odell, 08.23.1865  
 R2. Melton, Q815-A  
 R3. Tomkins, 91-21-C  
 R4. Tomkins, 00-31-C  
 R5. Flowers, 03-23-C  
 R6. Flowers, 05-135-B

- LEGEND**  
 ◆ SET 2 1/4" BRASS CAP ON A 1 1/8" x 30" GALVANIZED IRON PIPE. SEE FILED CORNER CERTIFICATE  
 ● SET A 5/8" x 24" IRON REBAR W/ A 1 1/8" RED PLASTIC CAP STAMPED ORLS 852 AND WALS 13922  
 ● FOUND 2 1/4" BRASS CAP FROM RECORD SURVEY AS LISTED.  
 X COMPUTED POINT

**DESCRIPTION OF TAX LOT 1400 AFTER BOUNDARY ADJSUTMENT**

A parcel of land located in the Southeast Quarter of the Northwest Quarter of Section 22, Township 6 North, Range 34 East of the Willamette Meridian, Umatilla County, Oregon;  
Further described as follows:  
Beginning at the northeast corner of said Southeast Quarter of the Northwest Quarter of said Section 22; Thence along the easterly line of said SE1/4 of the NW1/4, S 0°39'09"E, 463.00'; thence S87°42'52"W, 377.00'; thence to the north line of said SE1/4 of the NW1/4, N0°39'09"W, 463.005', thence along said north line, S87°42'52"E, 377.00' to the point of beginning, containing 4.01 acres.

TOGETHER with easement for ingress and egress 40 feet in width, centerline of which is described as being 20 feet North of Southeast corner of North Half of Northwest Quarter of Section 22; thence West, parallel with South line of said North Half of Northwest Quarter, 40 feet to the true point of beginning for this centerline description; thence East, parallel with South line of Northwest Quarter and parallel with South line of North Half of Northeast Quarter of said Section 22 to a point on Westerly right of way line of County Road No. 536, and point of terminus; Subject to any and all water rights of way and roads.  
ALSO SUBJECT TO:  
1. As disclosed by the tax rolls the premises herein described have been zoned or classified for farm use. At any time that said land is disqualified for such use said property will be subject to additional taxes and interest.  
2. Conditions contained in easements granted by Couse Creek Ranches, Inc., and Phillip Hoon to Helen Harris, for ingress and egress, recorded February 23, 1989, Microfilm R-176, Page 1646, Deed Records.

**NARRATIVE**

This survey was performed at the request of Mr. Ray Williams. The purpose of the survey was to adjust the boundary between Tax Lots 300 and 1400. The boundary lines of the SW1/4 of the NW1/4 and the SE1/4 of the NW1/4 of Section 22, Township 6 North, Range 34 East of the Willamette Meridian were established by the Standard BLM procedure for breaking a section down into quarter-quarter sections. The boundaries of the revised Tax Lot 1400 were determined from flagging marks in the field and the acreage requirements established by Mr. Williams. Mr. Williams supplied the record deed R492, Page 772.

Umatilla County Surveyor  
 Date 9-07  
 Rec'd By KK  
 No. 07-256B

REGISTERED PROFESSIONAL LAND SURVEYOR  
 David L. Haddock  
 OREGON  
 JULY 12, 1968  
 DAVID L. HADDOCK  
 52  
 RENEWS 6-30-09

PROJECT No.  
**SURVEY FOR**  
 Mr. Ray Williams  
 49654 Umapine Road  
 Milton Freewater, OR  
 97862  
 541-301-1385

MONUMENTS SET: 2007  
 David L. Haddock, Surveyor and Engineer  
 P.O. Box 1574  
 Pendleton, Oregon 97801  
 (541) 276-2174  
**HADDOCK SURVEYING**  
 GPS AND TOTAL STATION

AFFIDAVIT OF CORRECTION

STATE OF OREGON )  
COUNTY OF UMATILLA) S. S.

I, David L. Haddock, a Registered Professional Land Surveyor in the State of Oregon, being first duly sworn, depose and say that:


I am the Professional Land Surveyor who performed the survey for Raymond L. Williams which is filed as Umatilla County Survey No. 07-256-B. The "DESCRIPTION OF TAX LOT 1400 AFTER BOUNDARY ADJUSTMENT" should read as follows.

A parcel of land located in the Southeast Quarter of the Northeast Quarter of Section 22, Township 6 North, Range 34 East of the Willamette Meridian, Umatilla County, Oregon: Further described as follows:


Beginning at the northeast corner of said Southeast Quarter of the Northwest Quarter of said Section 22; thence along the easterly line of said SE1/4 of the NW1/4, S00°39'09"E, 463.00 feet; thence S87°42'52"W, 377.00 feet; thence to the north line of said SE1/4 of the NW1/4, N00°39'09"W, 463.00 feet; thence along said north line, N87°42'52"E, 377.00 feet to the point of beginning, containing 4.01 acres.

*David L. Haddock*

David L. Haddock  
Registered Land Surveyor 852LS  
State of Oregon

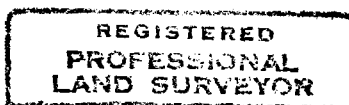

*David L. Haddock*

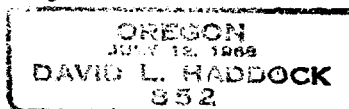

*RENEWALS: 6-30-09*

I, David H. Krumbein, Umatilla County Surveyor, do hereby certify that I have examined this Affidavit of Correction and that it complies with the requirements of ORS 209.255.

*David H. Krumbein*

David H. Krumbein  
Umatilla County Surveyor

After Recording, Return To:  
David L. Haddock, PLS  
P. O. Box 1574  
Pendleton, OR 97801

(541) 276-2174

46  
2

2010 5690298



2010-5690298 1 of 2

AFFIDAVIT OF CORRECTION (BOUNDARY ADJUSTMENT PLAT)

State of Oregon)  
SS  
Umatilla County)

I, David L. Haddock, being duly sworn, depose that I am the surveyor who prepared the Plat recorded as , Umatilla County Survey 07-256-B, recorded in June, 2007 in the Umatilla County Surveyor's Office.

The following corrections to said "BOUNDARY ADJUSTMENT" drawing are necessary and are as follows:


1. The word "ADJSUTMENT" on the right hand side of the drawing should be spelled "ADJUSTMENT" both times.
2. The following words in the "NARRATIVE" should be corrected:  
"Satndard" should be "Standard".  
"established should be "established".
3. The second paragraph in the "DESCRIPTION OF TAX LOT 1400 AFTER BOUNDARY ADJUSTMENT" should read as follows:

A parcel of land located in the Southeast Quarter of the Northwest Quarter of Section 22, Township 6 North, Range 34 East of the Willamette Meridian, Umatilla County, Oregon; Beginning at the northeast corner of said Southeast Quarter of the Northwest Quarter of said Section 22; thence along the easterly line of said SE1/4 of the NW1/4, S0°39'09"E, 463.00 feet, thence S87°42'52"W, 377.00 feet, thence to the north line of said SE1/4 of the NW1/4, N0°39'09"W, 463.00 feet, thence along said north line, S87°42'52"E, 377.00 to the point of beginning containing 4.01 acres.


DLH  
8-13-2010

*David L. Haddock*

David L. Haddock  
Registered Professional Land Surveyor No. 852

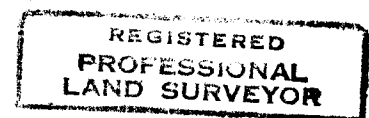


*David L. Haddock*

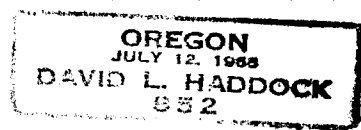

This instrument was acknowledged before me on this 10TH day of AUGUST, 2010.

by David L. Haddock.

*Steve Churchill*  
Notary Public for the State of Oregon.  
My Commission Expires: 08-14-2010

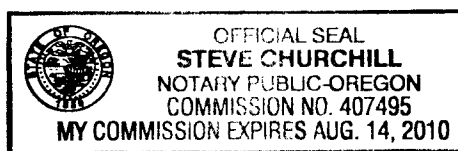

My Commission Number: 407495


RENEWS 6-30-11

Names of the present fee owners affected by this correction are : T. O. Williams and Associates Inc.

I, David Krumbein, Umatilla County Surveyor, do hereby certify that said affidavit of correction for Umatilla County Survey 07-256-B, has been examined by me and that it complies with O. R. S. 92.170.

*David H. Krumbein*  
David H. Krumbein  
Umatilla County Surveyor

RETURN TO:  
David L. Haddock  
P. O. Box 1574  
Pendleton, OR 97801

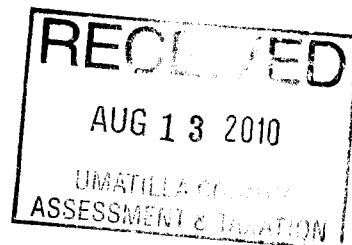

State of Oregon     )  
                          )  
County of Umatilla    )

This instrument was received  
and recorded on

08-13-10 at 3:15

in the record of instrument  
code type DE-AFF

Instrument Number 2010-5690298  
Fee 48.00

Office of County Records

  
\_\_\_\_\_  
Records Officer



2010-5690298 2 of 2