



LAND PARTITION - BOUNDARY  
 FOR  
 HERMISTON SEVENTH DAY ADVENTISTS  
 IN  
 NE $\frac{1}{4}$ , NW $\frac{1}{4}$ , SEC. 15, T. 4 N., R. 28 E., W. M.  
 UMATILLA CO. OREG.

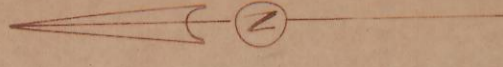

P-82-A

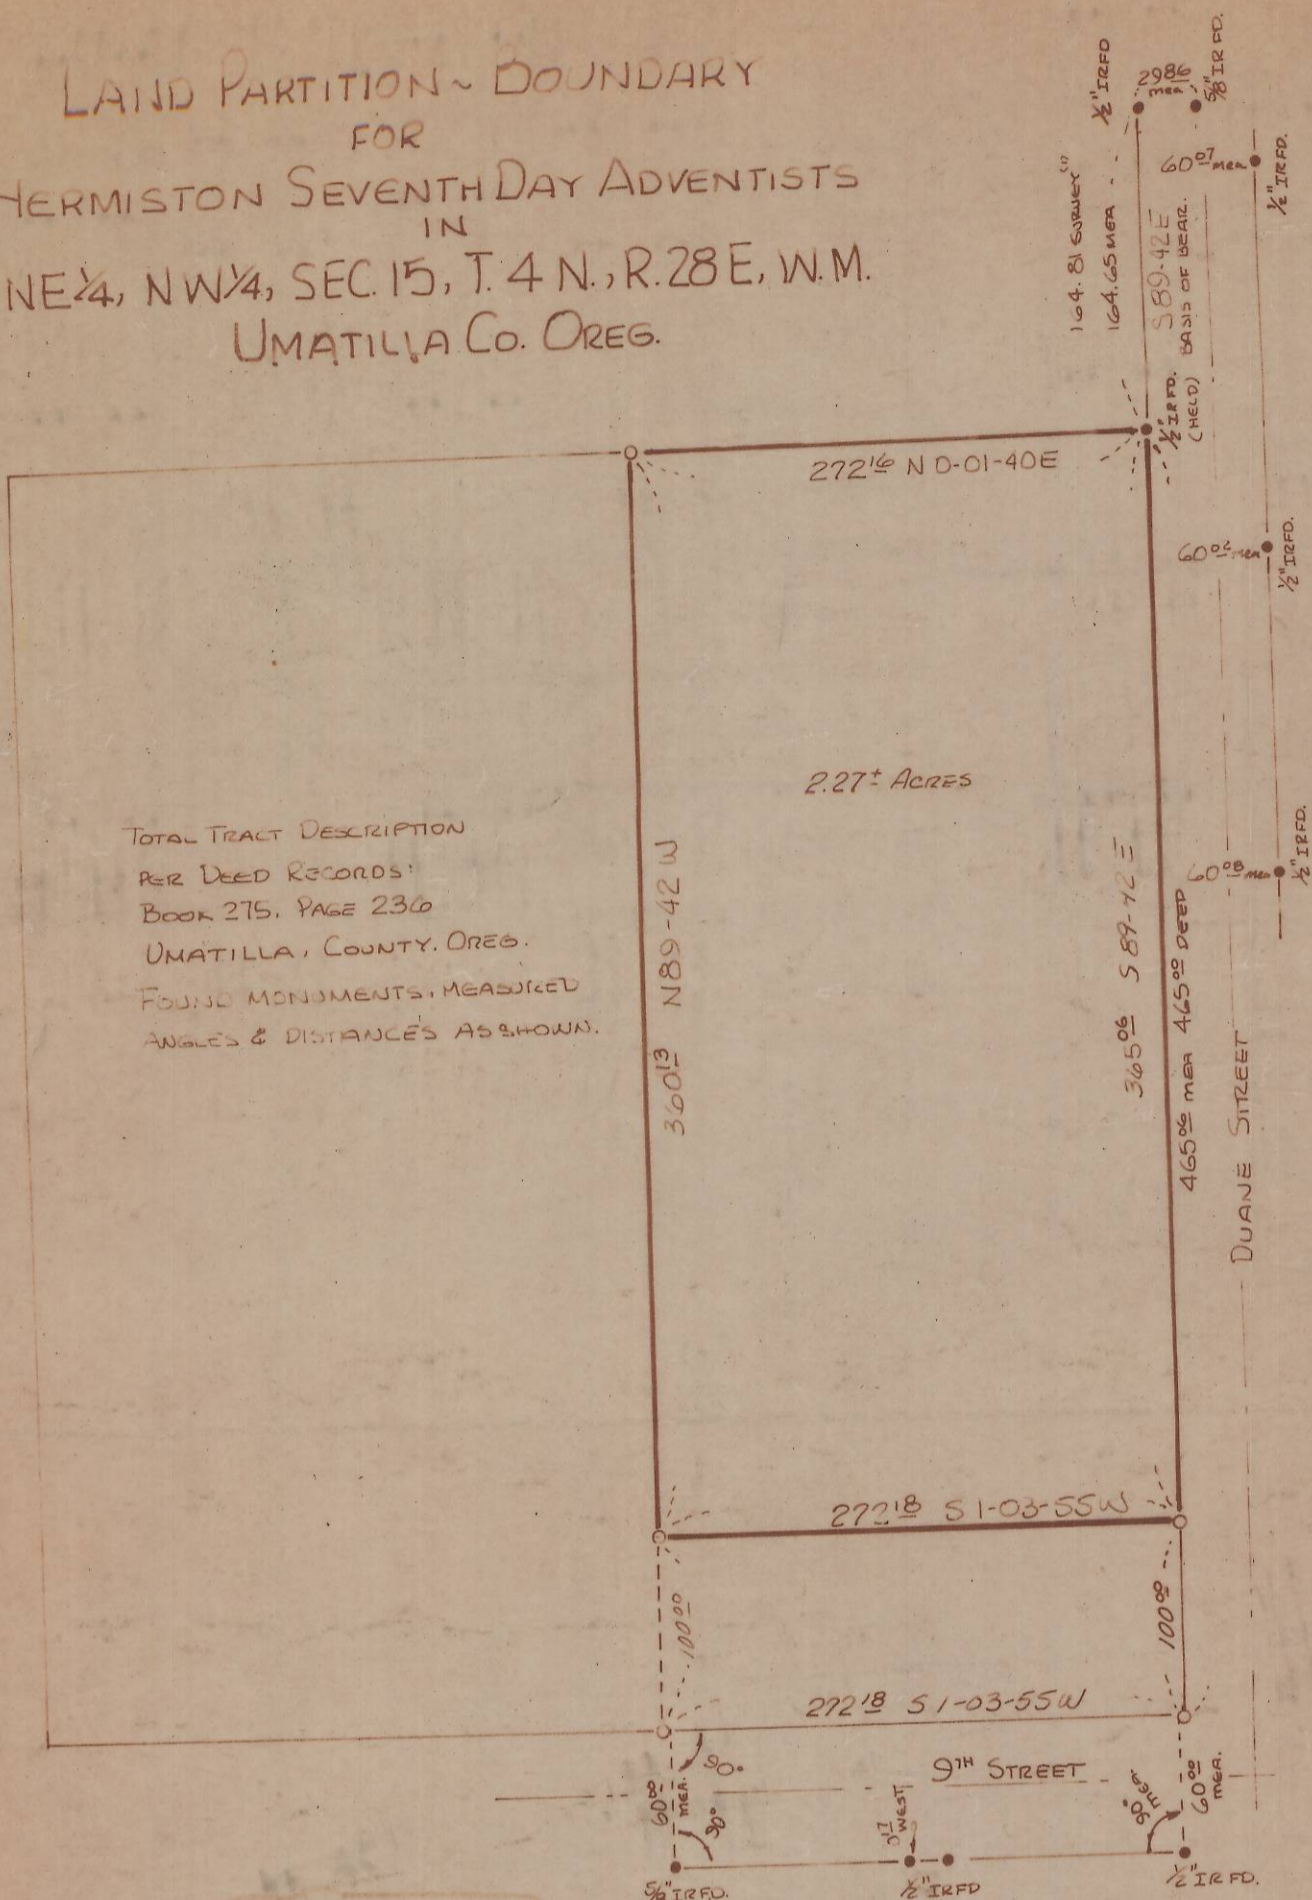

TOTAL TRACT DESCRIPTION  
 PER DEED RECORDS:  
 BOOK 275, PAGE 236  
 UMATILLA, COUNTY, OREG.  
 FOUND MONUMENTS, MEASURED  
 ANGLES & DISTANCES AS SHOWN.

PROFESSIONAL  
 LAND SURVEYOR  
 Bruce Golden  
 OREGON  
 BRUCE B. GOLDSON  
 1978-001

BRUCE GOLDSON  
 HERMISTON, OREGON.

- NOTES:
1. ● DENOTES MONUMENTS FOUND
  2. ○ DENOTES IRON RODS SET (5/8" x 24")
  3. REF RECORD SURVEY:  
 EDWARDS SURVEYING, 4/10/76, #K-93.
  4. DATE: MAY 5, 1978; SCALE 1"=100'

P-82-A

P-82-A