

OREGON CORNER RESTORATION FORM

Section 32 Township 3N Range 30E
 County Umatilla Date: September 14, 2016


Corner Designation: 3N30V5

Condition Report Only
 Not found
 Remonumented
 Unrecorded
 Surveyed in
 Referenced out

Corner to sections 29, 30, 31, and 32, T3N, R30E,
 W.M., Umatilla County, Oregon.

Previous Renewals / Surveys, etc.
 Corner was originally set by William B. Campbell under contract No. 95 dated September 19, 1860
 His record reads: Set a post for corner to secs. 29, 30, 31 and 32. Drove charred stake and
 raised mound of earth, with trench and pits as per instructions. In survey Q-516-B Mr. Wayne
 Harris called for a stone and 1/2" I.P..

Monument and Accessories found: (condition and source)
 None. This point falls in a road cut.

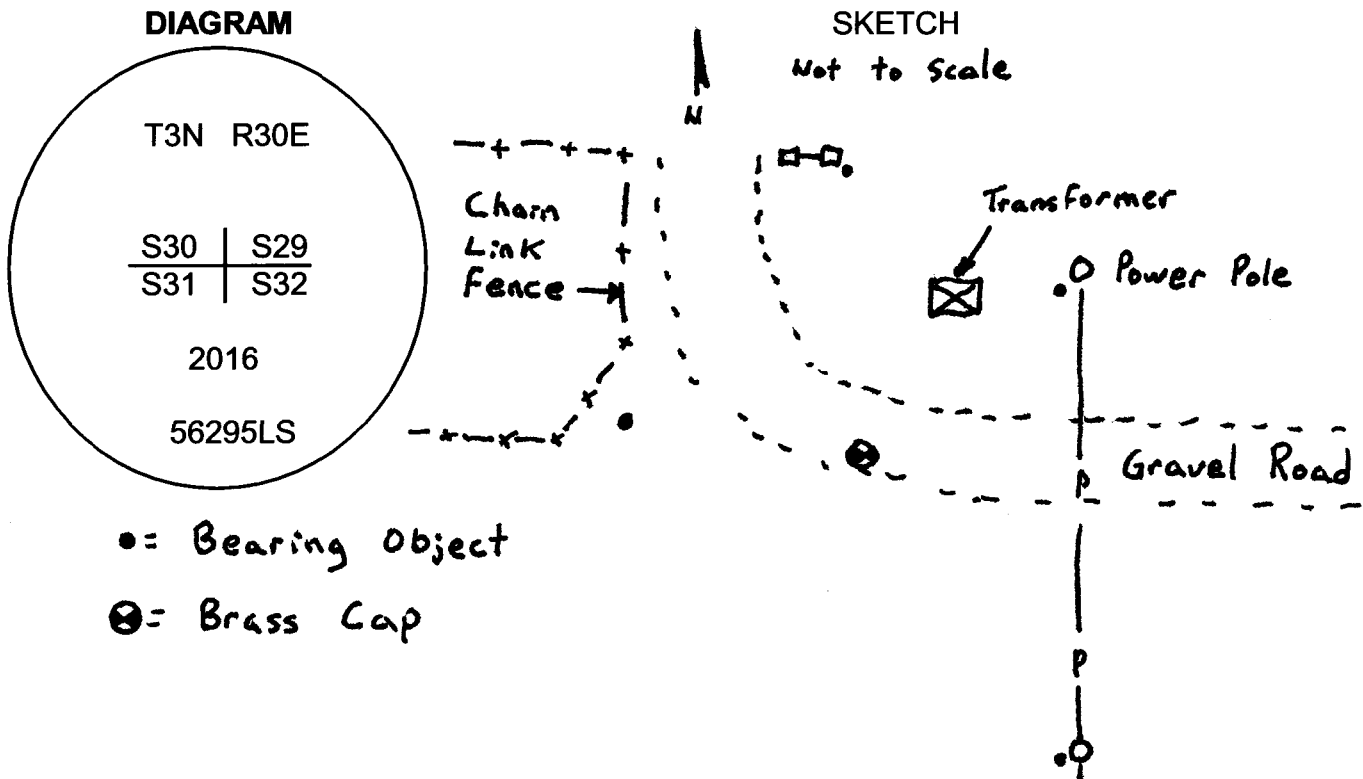

• = Bearing Object
 ⊗ = Brass Cap

MONUMENT (S) AND ACCESSORIES SET (Procedures and Description)
 At the position determined from ties to the chain link fence enclosure around the site from survey
 Q-516-B I set a 1 1/2"x30" galvanized iron pipe with brass cap attached 36" in the ground. The
 cap is stamped as shown in the diagram above.

For references I set three 5/8"x30" iron rebars with orange plastic caps attached stamped WTS
 and 56295LS as described below:
 An iron rebar bears N65°23'02"W, 31.83 feet;
 An iron rebar bears N01°34'28"W, 67.91 feet;
 A 1/2 inch smooth iron power pole ground rod bears N49°07'54"E, 37.15 feet;
 An iron rebar bears S35°37'15"E, 49.06 feet;

The monument was set and references were tied using a Trimble R7/R8 RTK GPS system.

Location and comments

Compass Declination

Surveyors Seal

RECEIVED BY:
 Umatilla County Surveyor
 Date: 2/2/2017
 Rec'd By: [Signature]
 No. 17-005-B

Firm / Agency
 Witness Tree Surveying
 Address
 P.O. Box G
 Pilot Rock, Or. 97868
 Party Chief
 Stephen K, Haddock

REGISTERED
 PROFESSIONAL
 LAND SURVEYOR

[Signature: Stephen K. Haddock]

OREGON
 JULY 9, 2001
 STEPHEN K. HADDOCK
 56295LS

RENEWS: 6-30-17