

1M-225

T4N-R29E

1M-223

CHAINED SCALE

0 10,496 10

NZ-1MM-143

1E-253 H6



19 20
30 29

20 21
29 28

21 22
28 27

FEEVILLE ROAD

CANAL ROAD

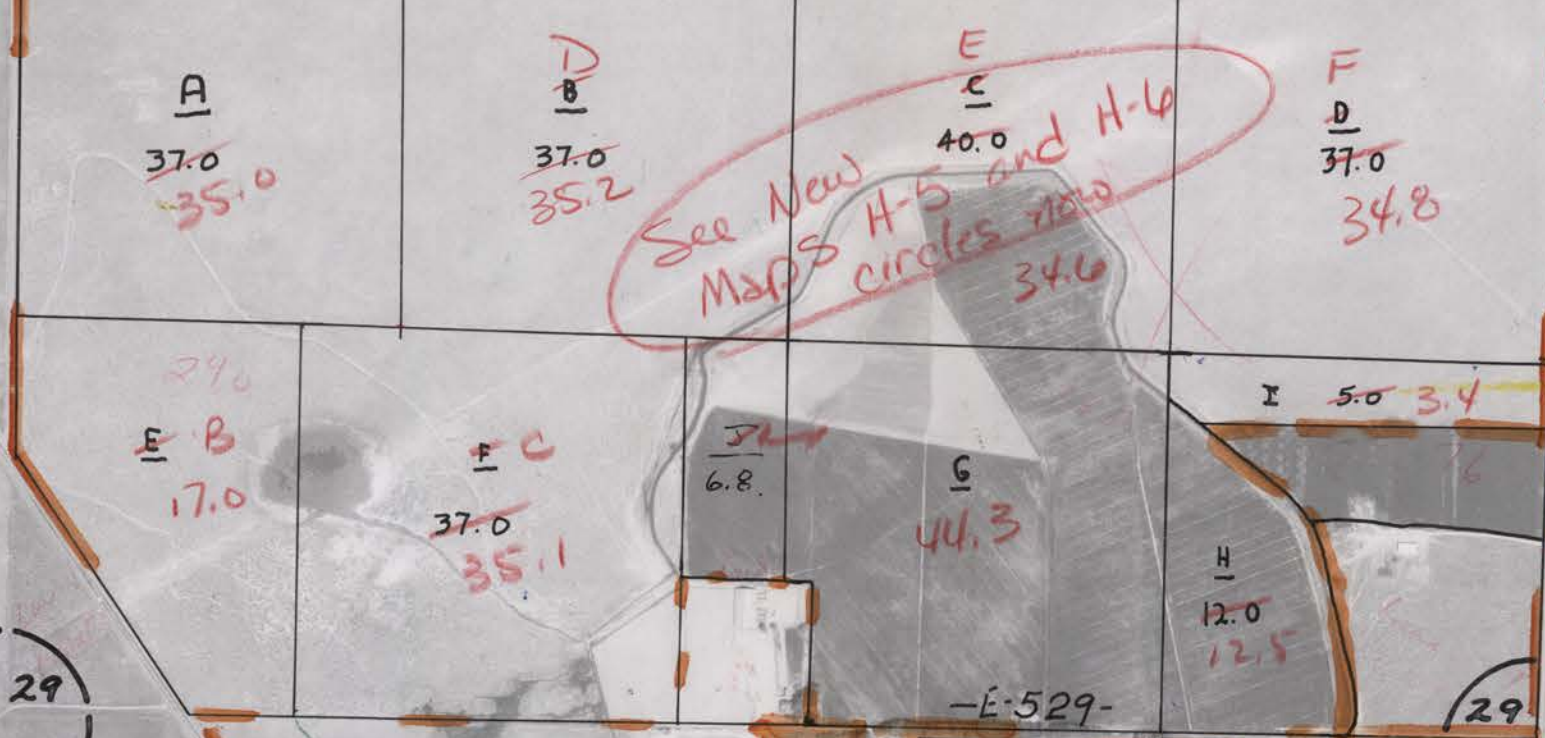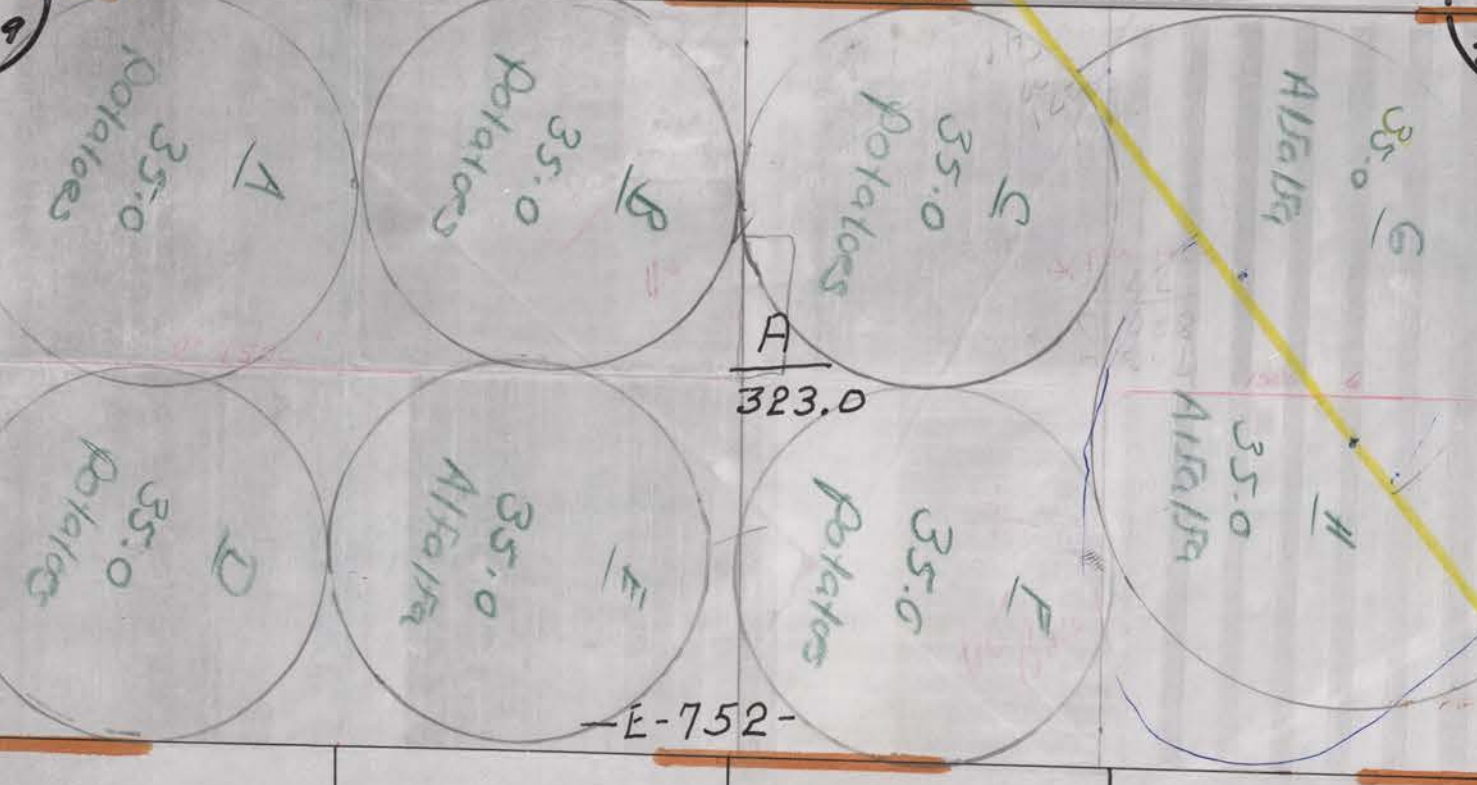

1M-141

30 29
31 32

29 28
32 33

29 27
33 34

1M-144

Roy M. Crunk, Hank K. et al

5-12-71

31 32
6 5

32 33
5 4

33 34
4 3

STANFIELD

1M-113

1M-111