

171 L 4

T1S-R30E

10T




T 767

T 861

S9

SEE MAP  
11 T

(261.6)

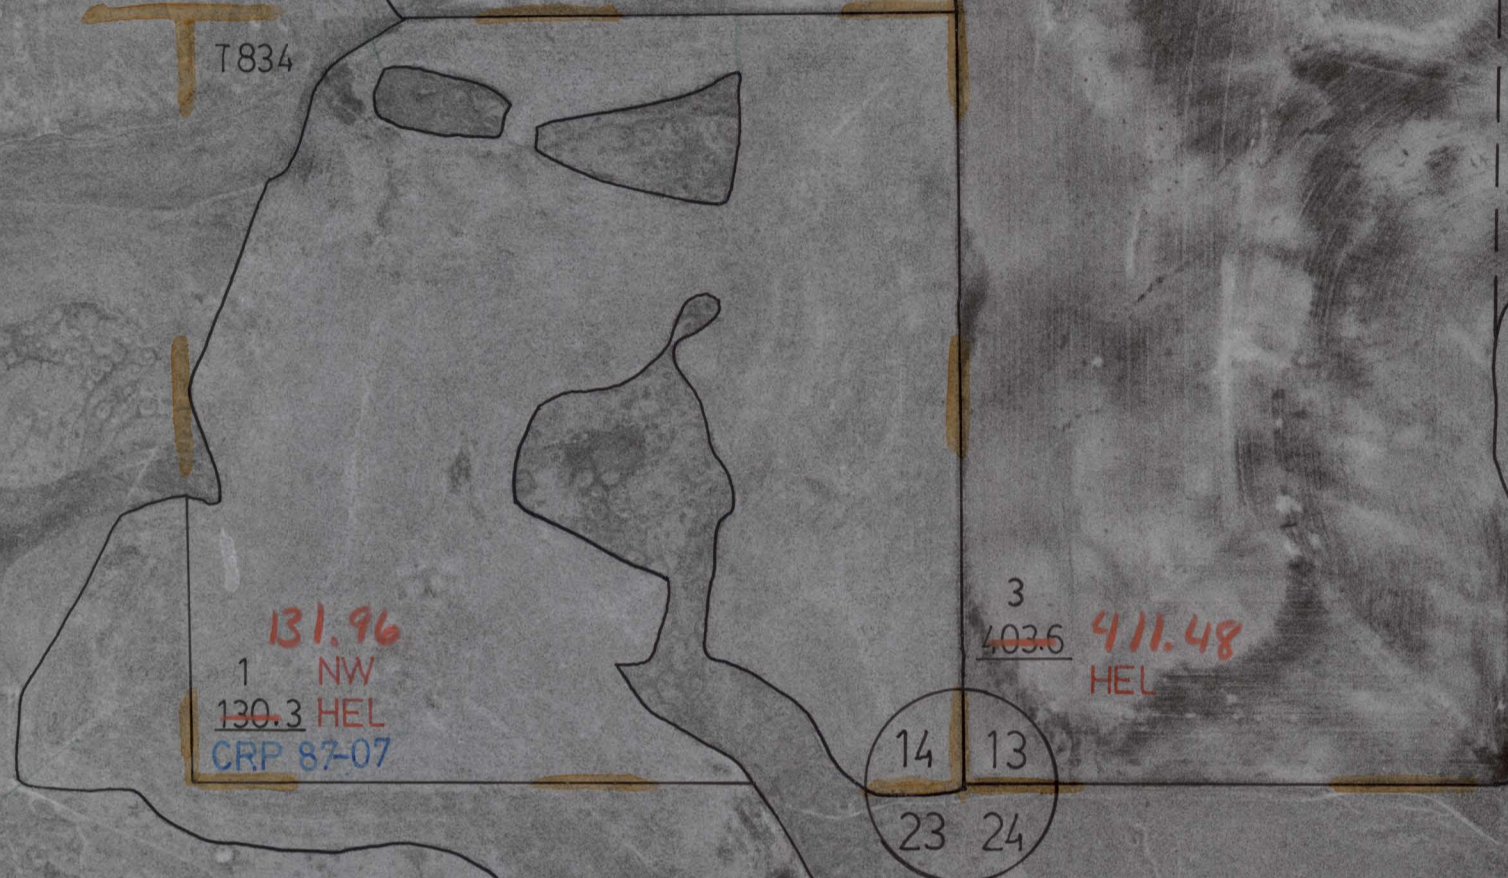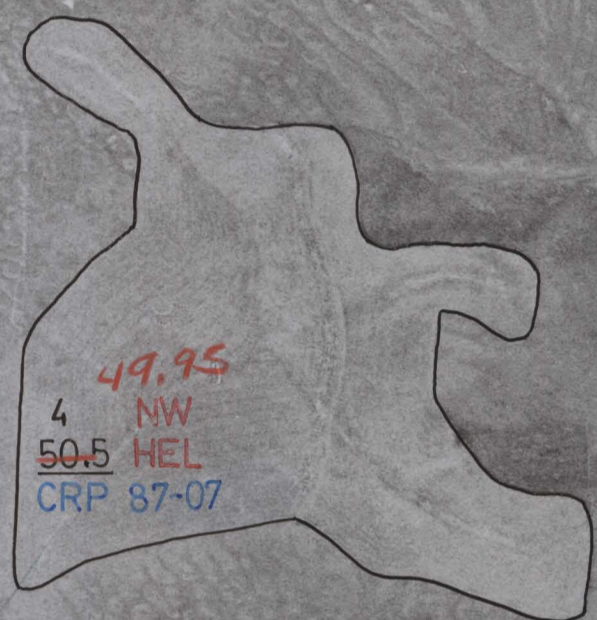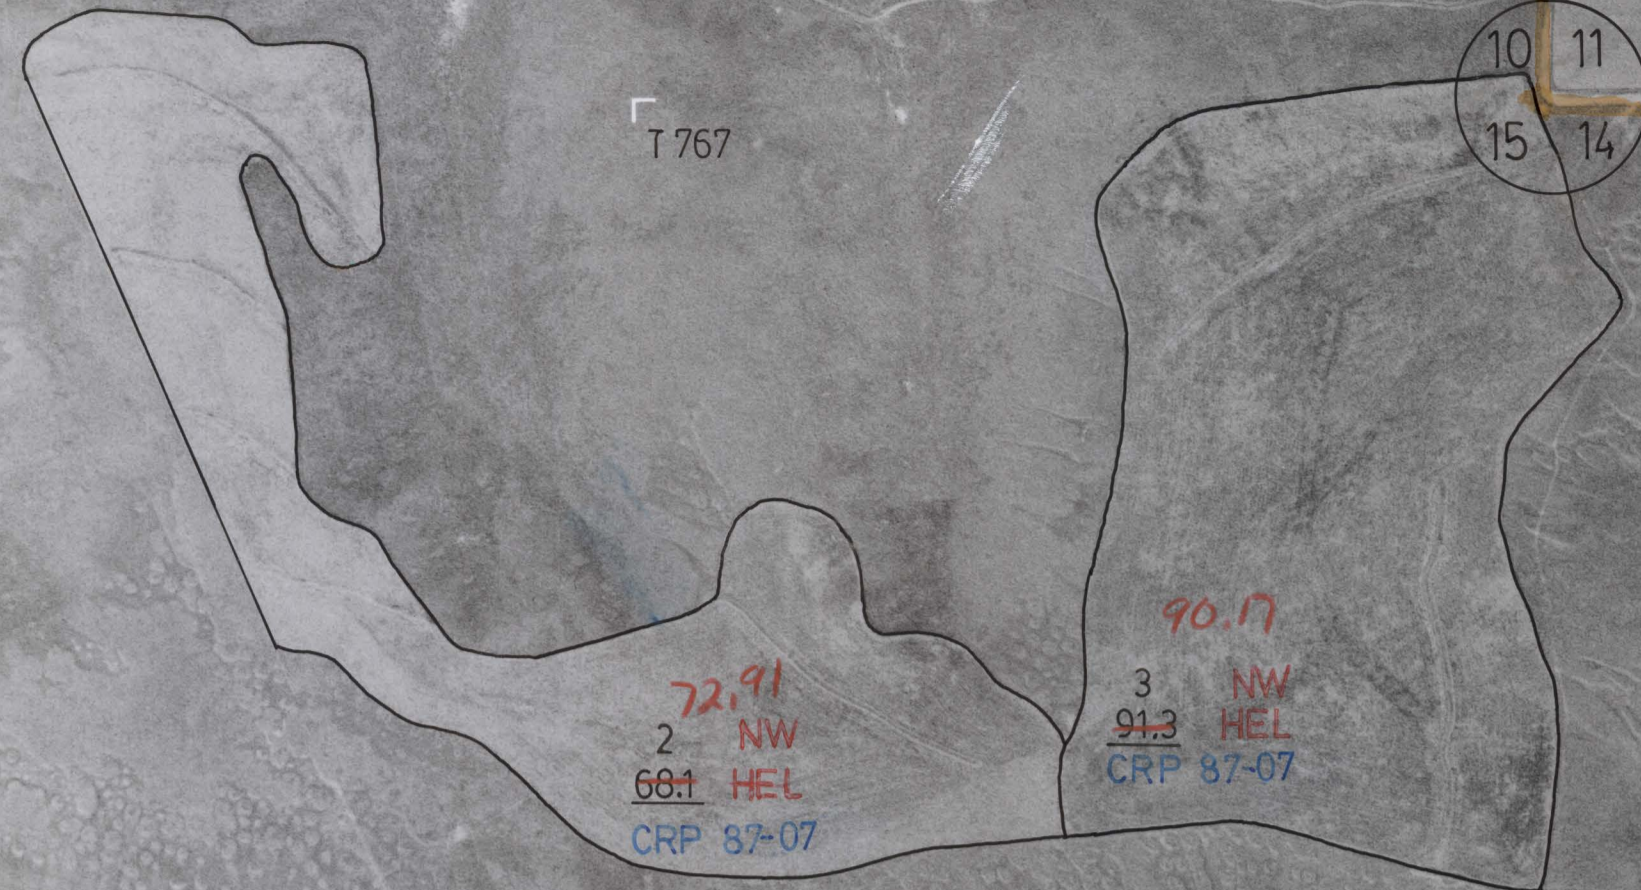

16 15  
21 22

15 14  
22 23

14 13  
23 24

22 23  
27 26

23 24  
26 25

T 3162

T 834