

☪ NAPP-7016

CHAINED SCALE
6914


169 R 14

11 V
U 9

T1S-R30E

T1S-R30 1/2 E

T1S-R31E




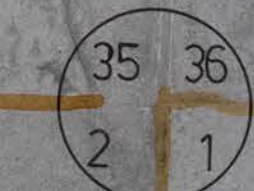


T1852

T2S-R30E

T2S-R30 1/2 E

T2S-R31E

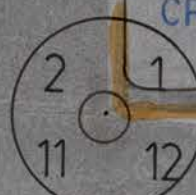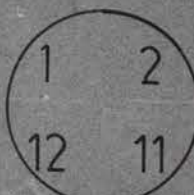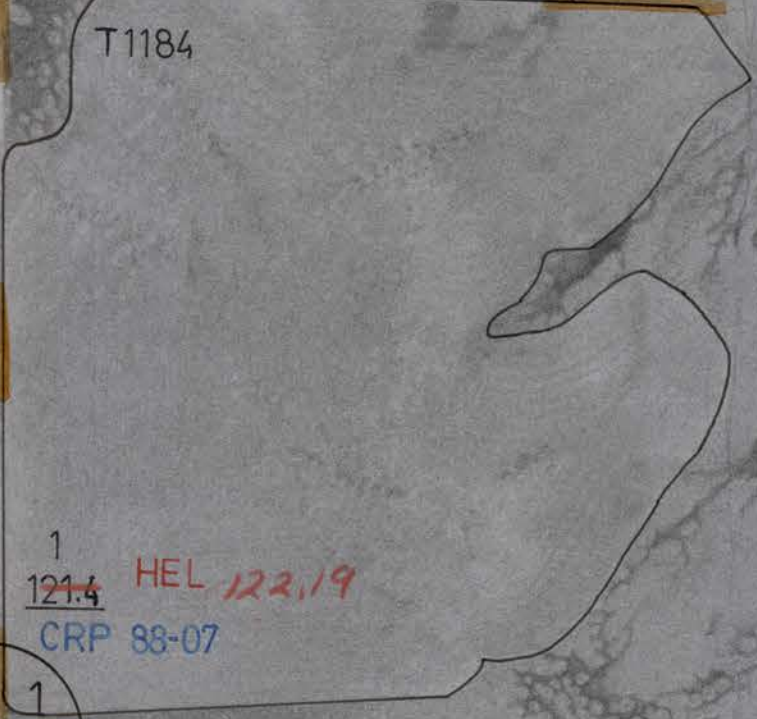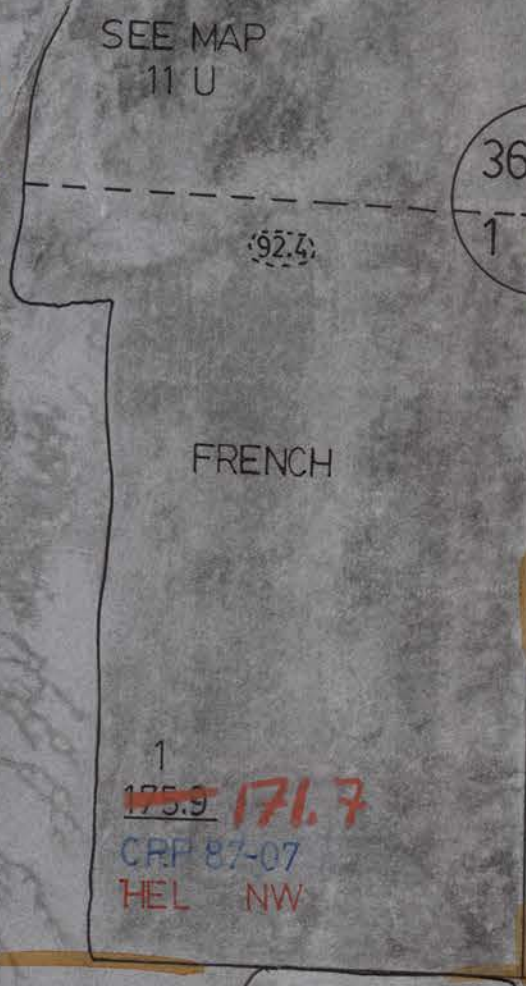

RANCHERIA EAST

