


NAPP 7014 41EC 31

15R-2

T1N-R32E

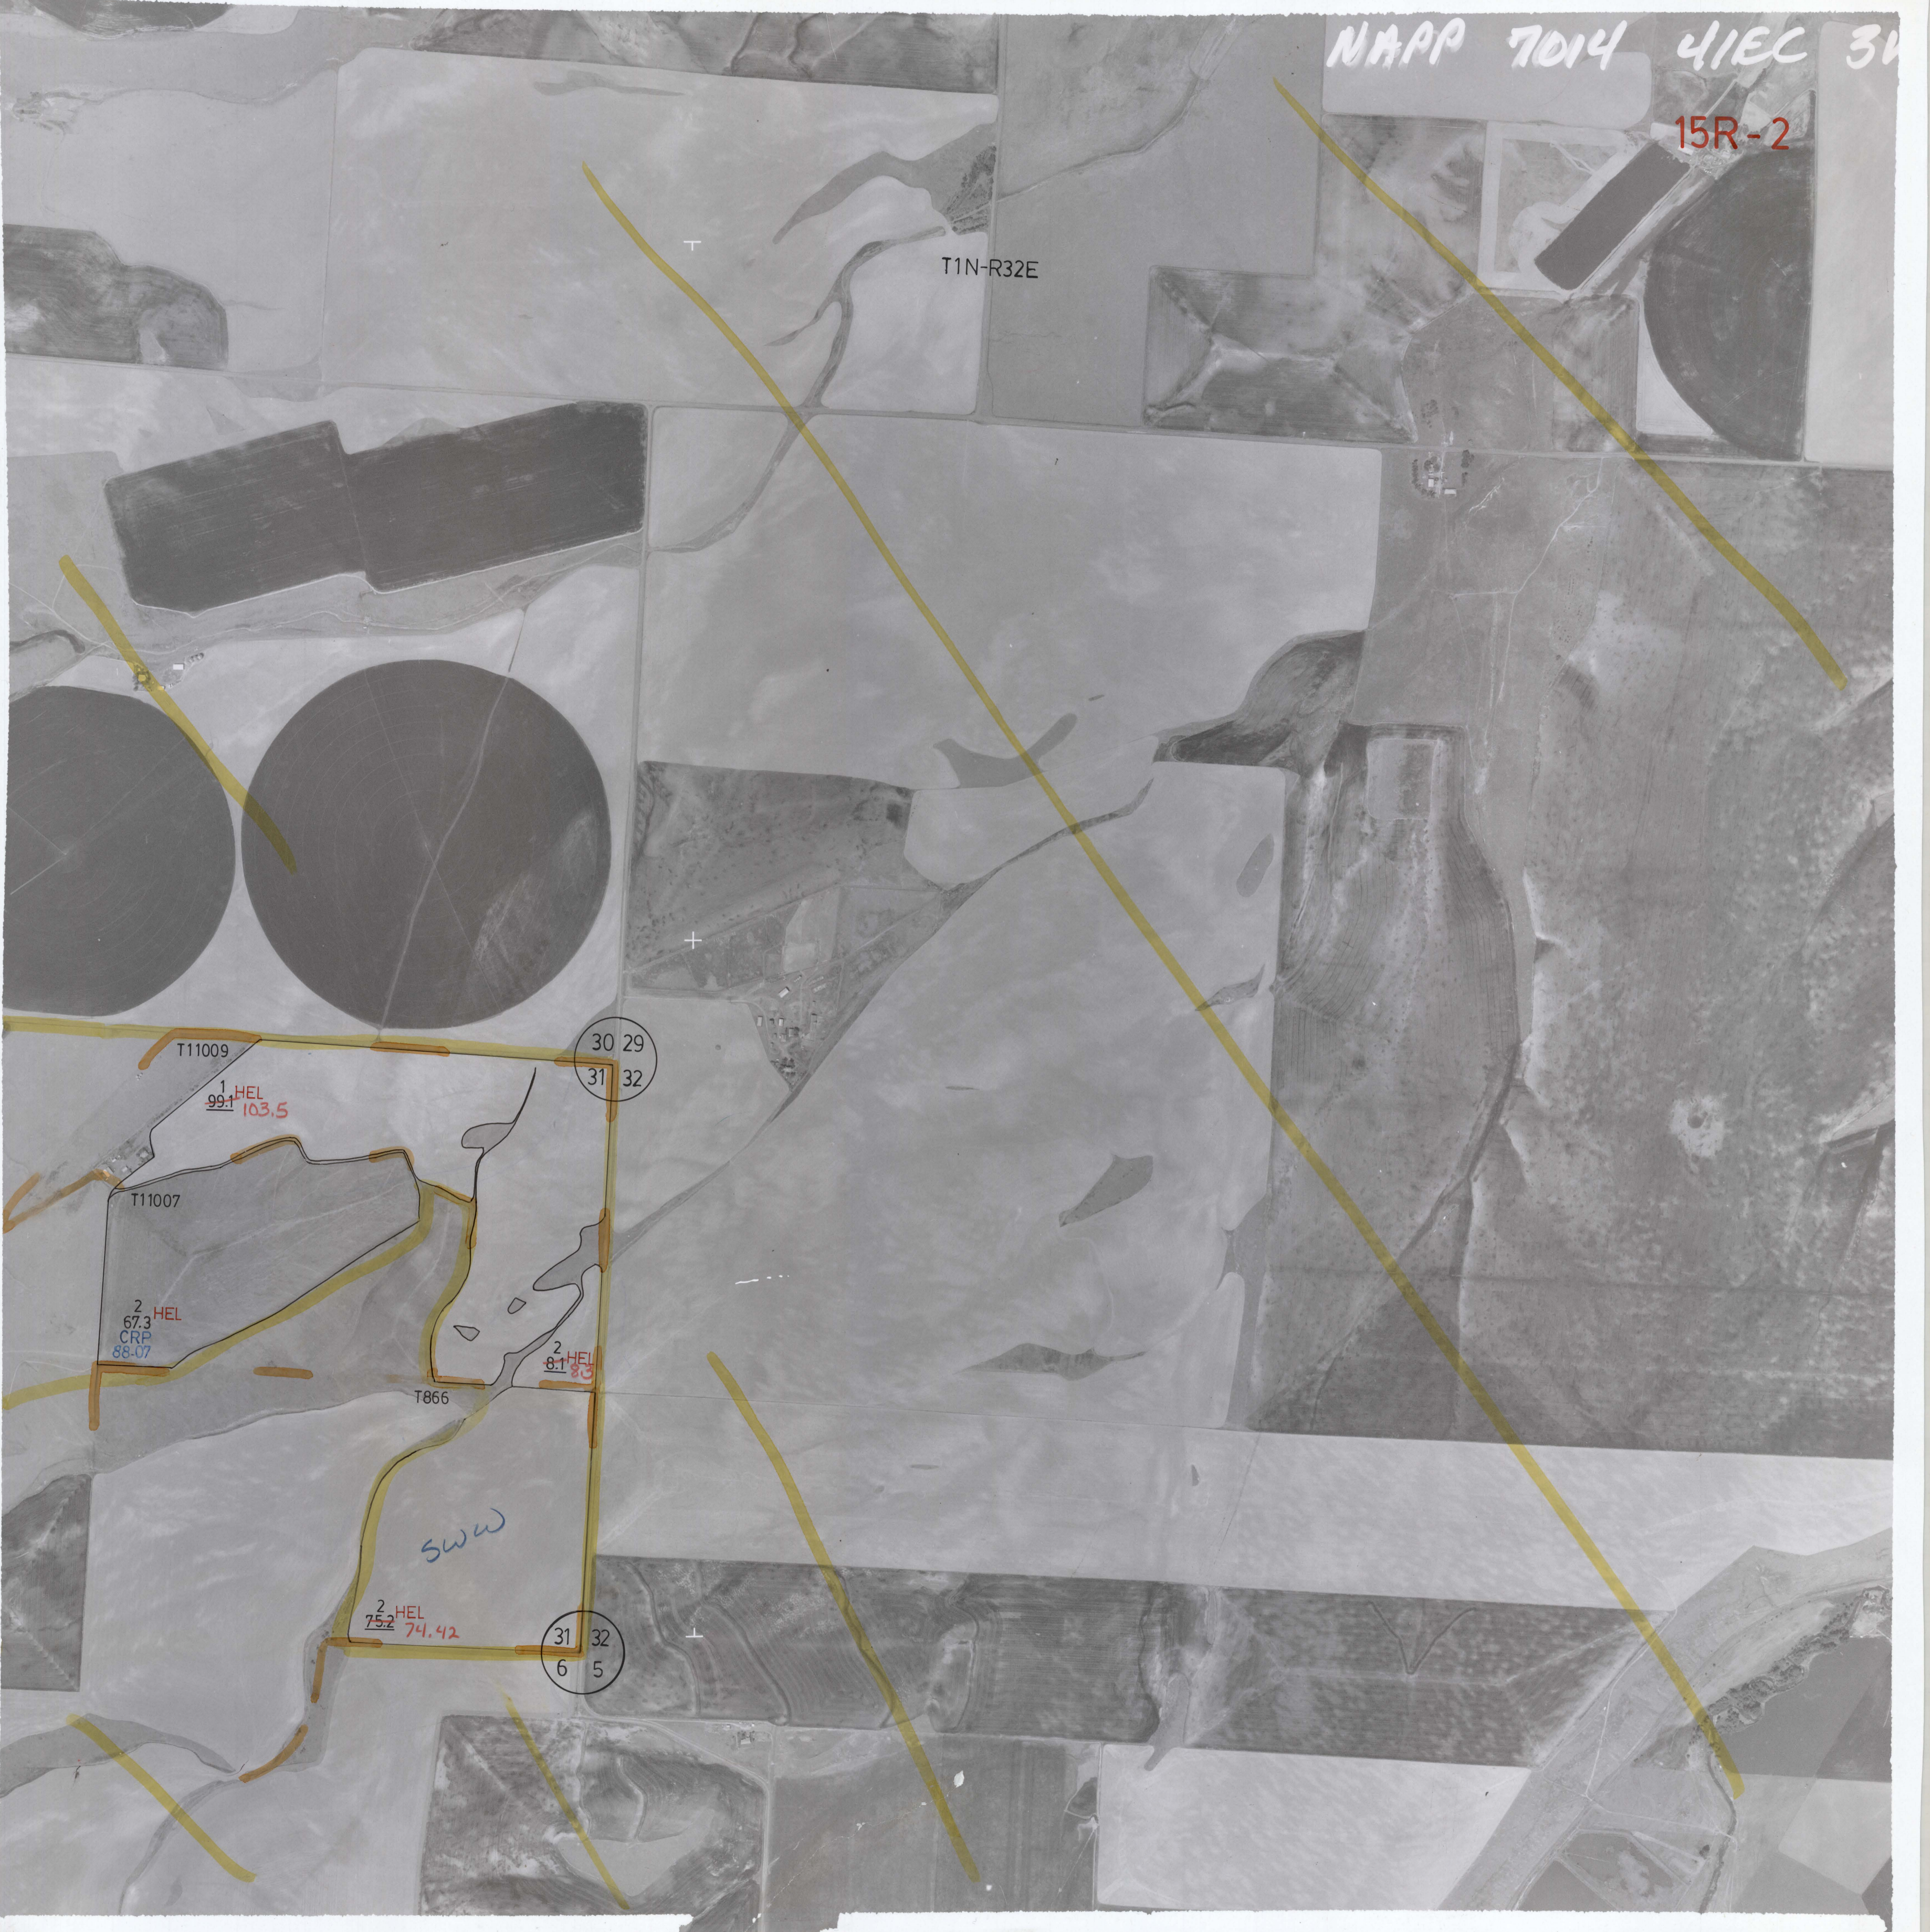

T11009

1 HEL
99.1 103.5

30 29
31 32

T11007

2 HEL
67.3
CRP
88-07

2 HEL
8.1 8.3

T866

SWW

2 HEL
75.2 74.42

31 32
6 5