


T2N-R34E

21 N - 1

M 18

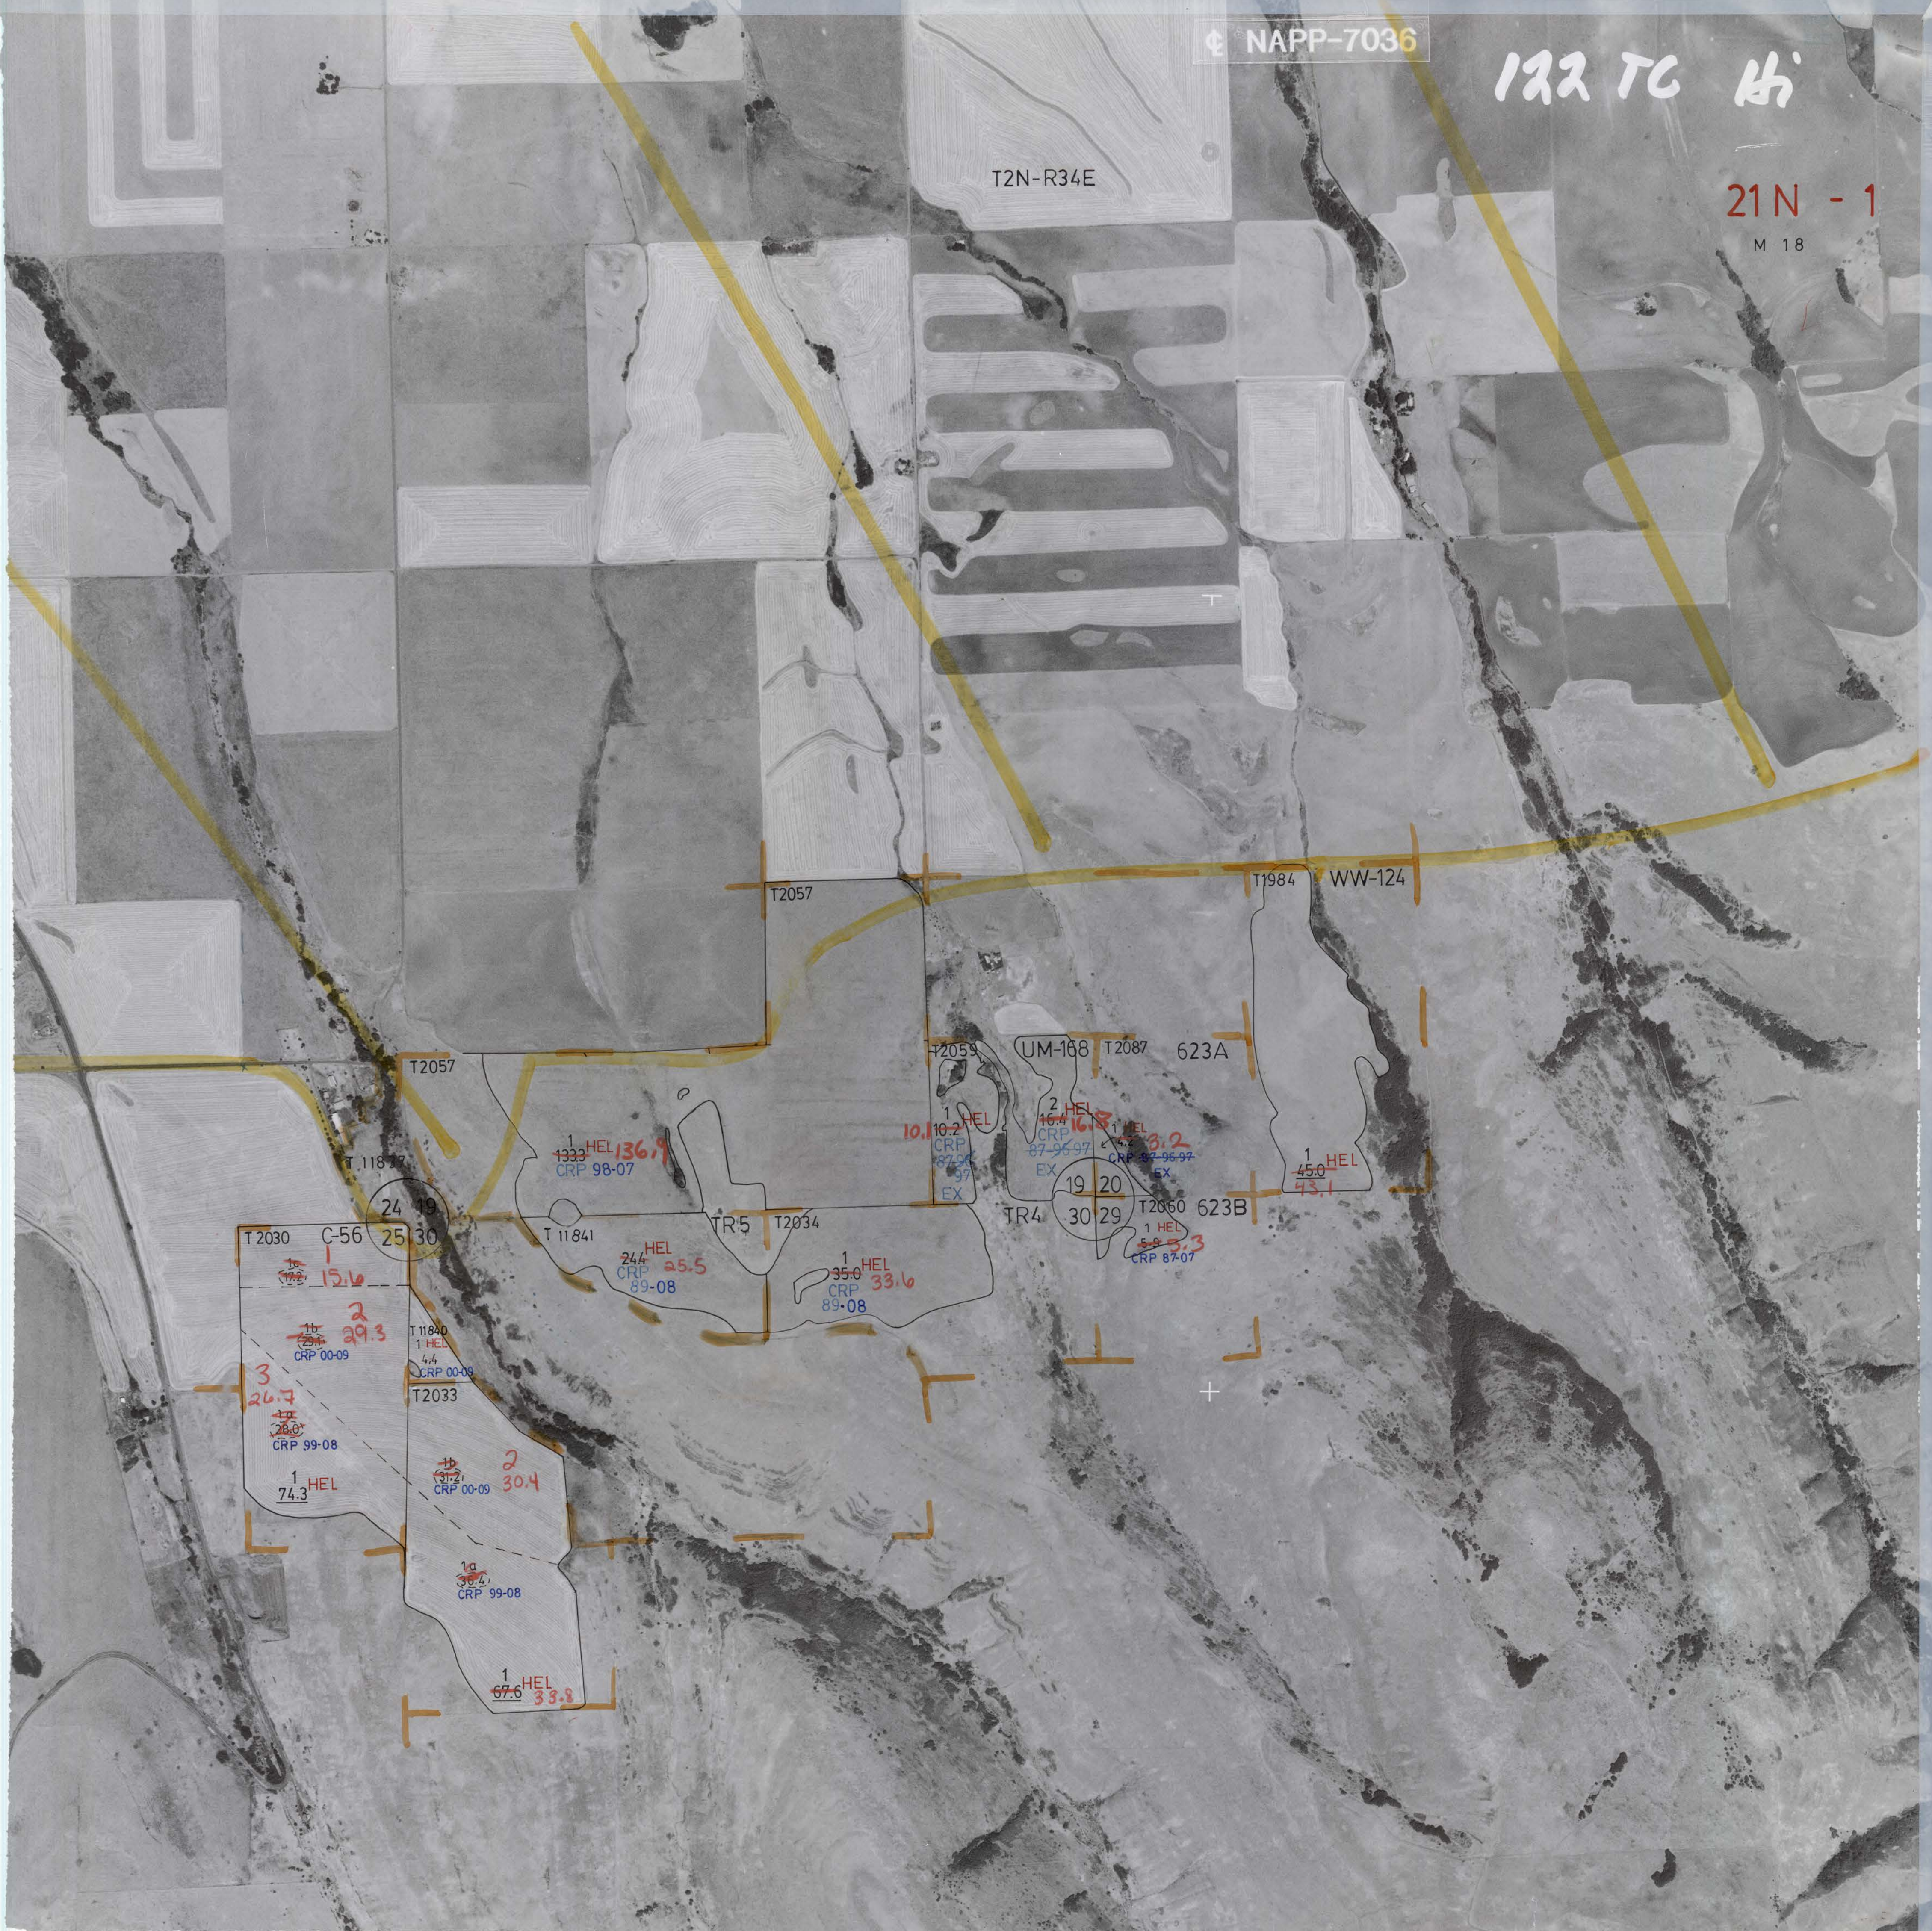

T2057

T1984

WW-124

T2057

T2059

UM-168

T2087

623A

T 11841

1333 HEL 136.9
CRP 98-07

10.10.2 HEL
CRP 87-96
97 EX

16.4 HEL
CRP 87-96-97
EX

1 HEL
CRP 87-96-97
EX

1 HEL
45.0
43.1

T 2030 C-56 24 19
25 30

1 HEL
15.6

2 HEL
29.3
CRP 00-09

3 HEL
26.7
26.0
CRP 99-08

1 HEL
74.3

T 11840
1 HEL
4.4
CRP 00-09

T2033

2 HEL
30.4
CRP 00-09

1a HEL
36.4
CRP 99-08

1 HEL
67.6
33.8

T 11841

244 HEL
CRP 89-08
25.5

TR5 T2034

1 HEL
35.0
CRP 89-08
33.6

TR4

19 20
30 29
1 HEL
5.9
CRP 87-07
3.3

T2060 623B