


261 EC 111

24 M

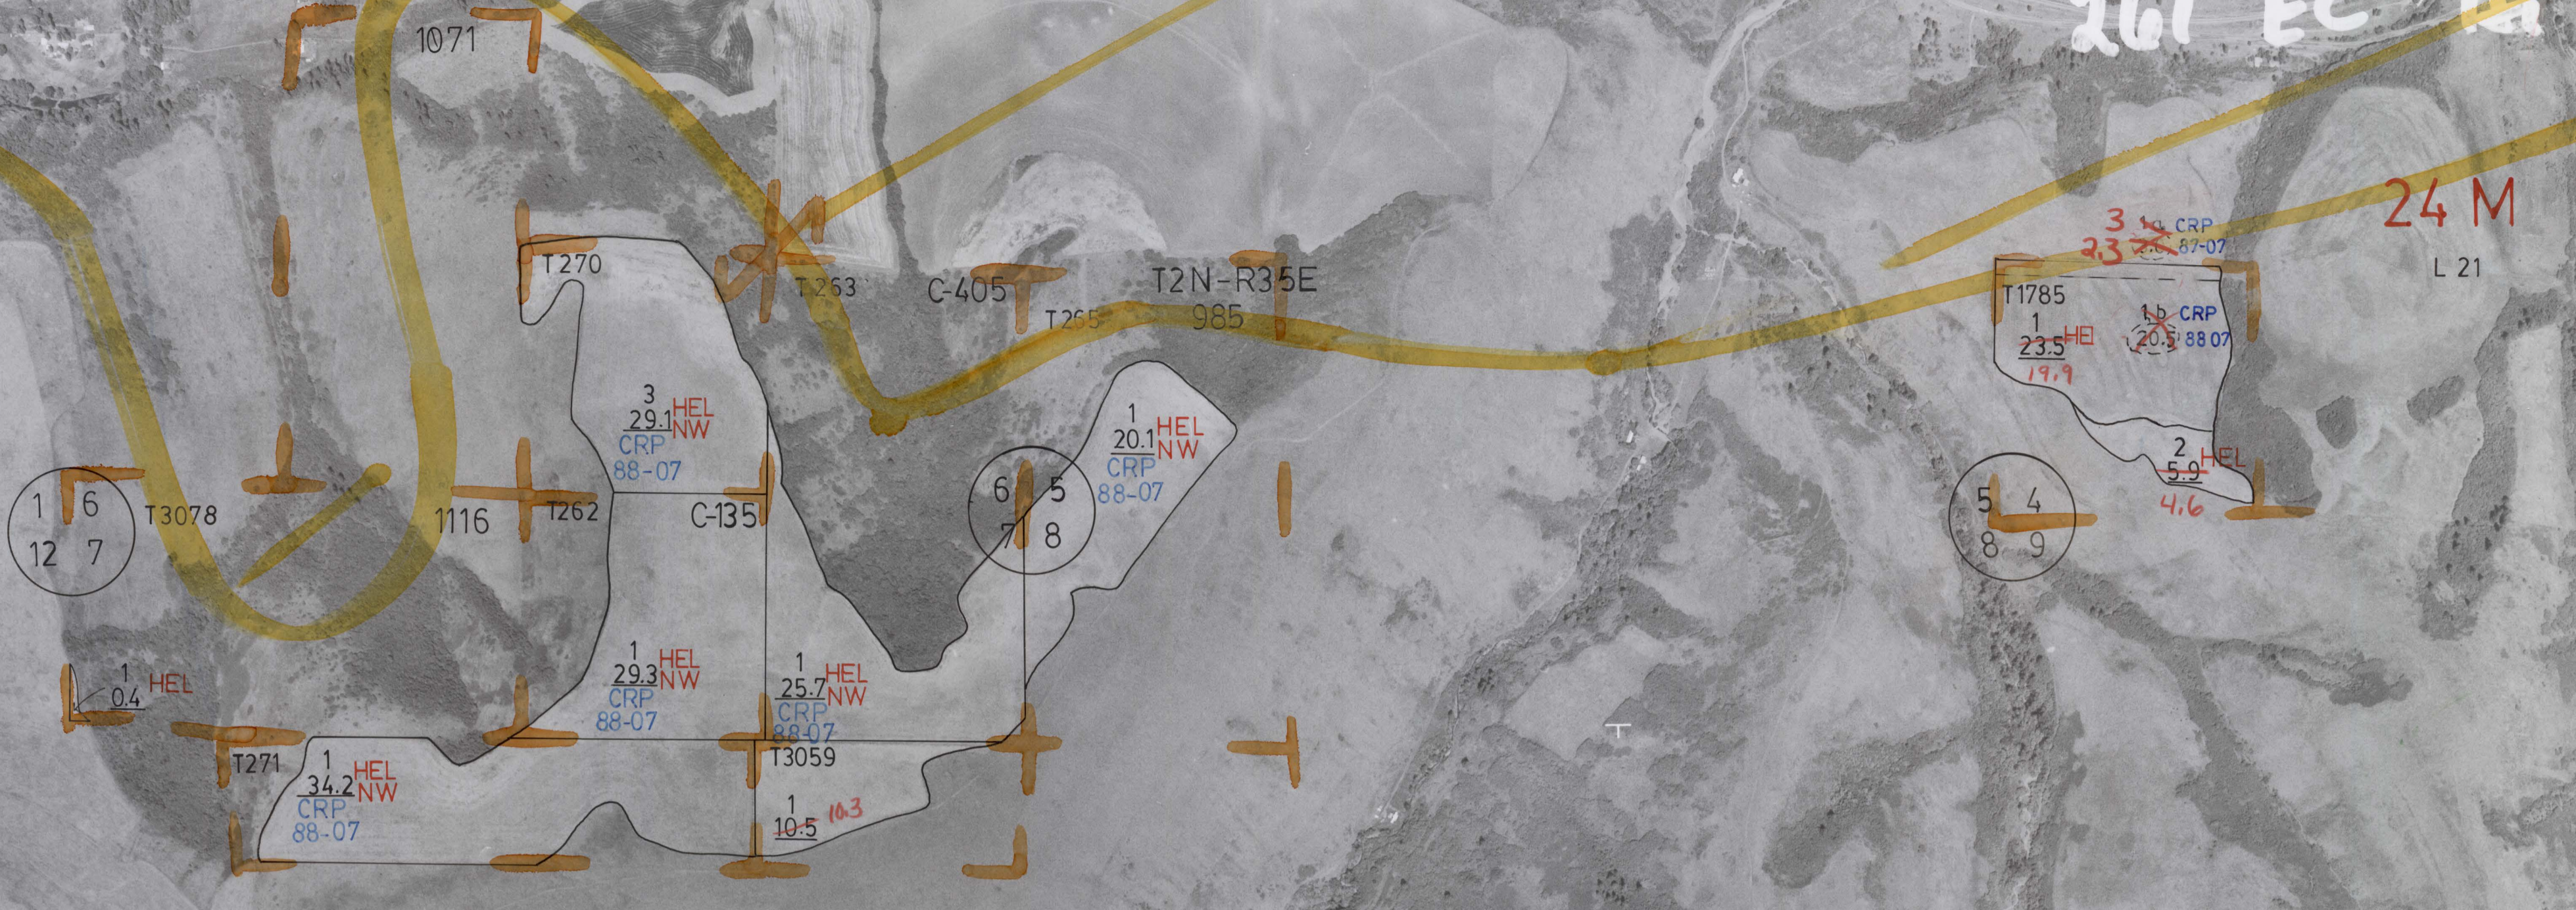

1	6
12	7

6	5
7	8

5	4
8	9

12	7
13	18

7	8
18	17

8	9
17	16

13	18
24	19

18	17
19	20

17	16
20	21