


T6N-R35E

22 23
27 26

23 24
26 25

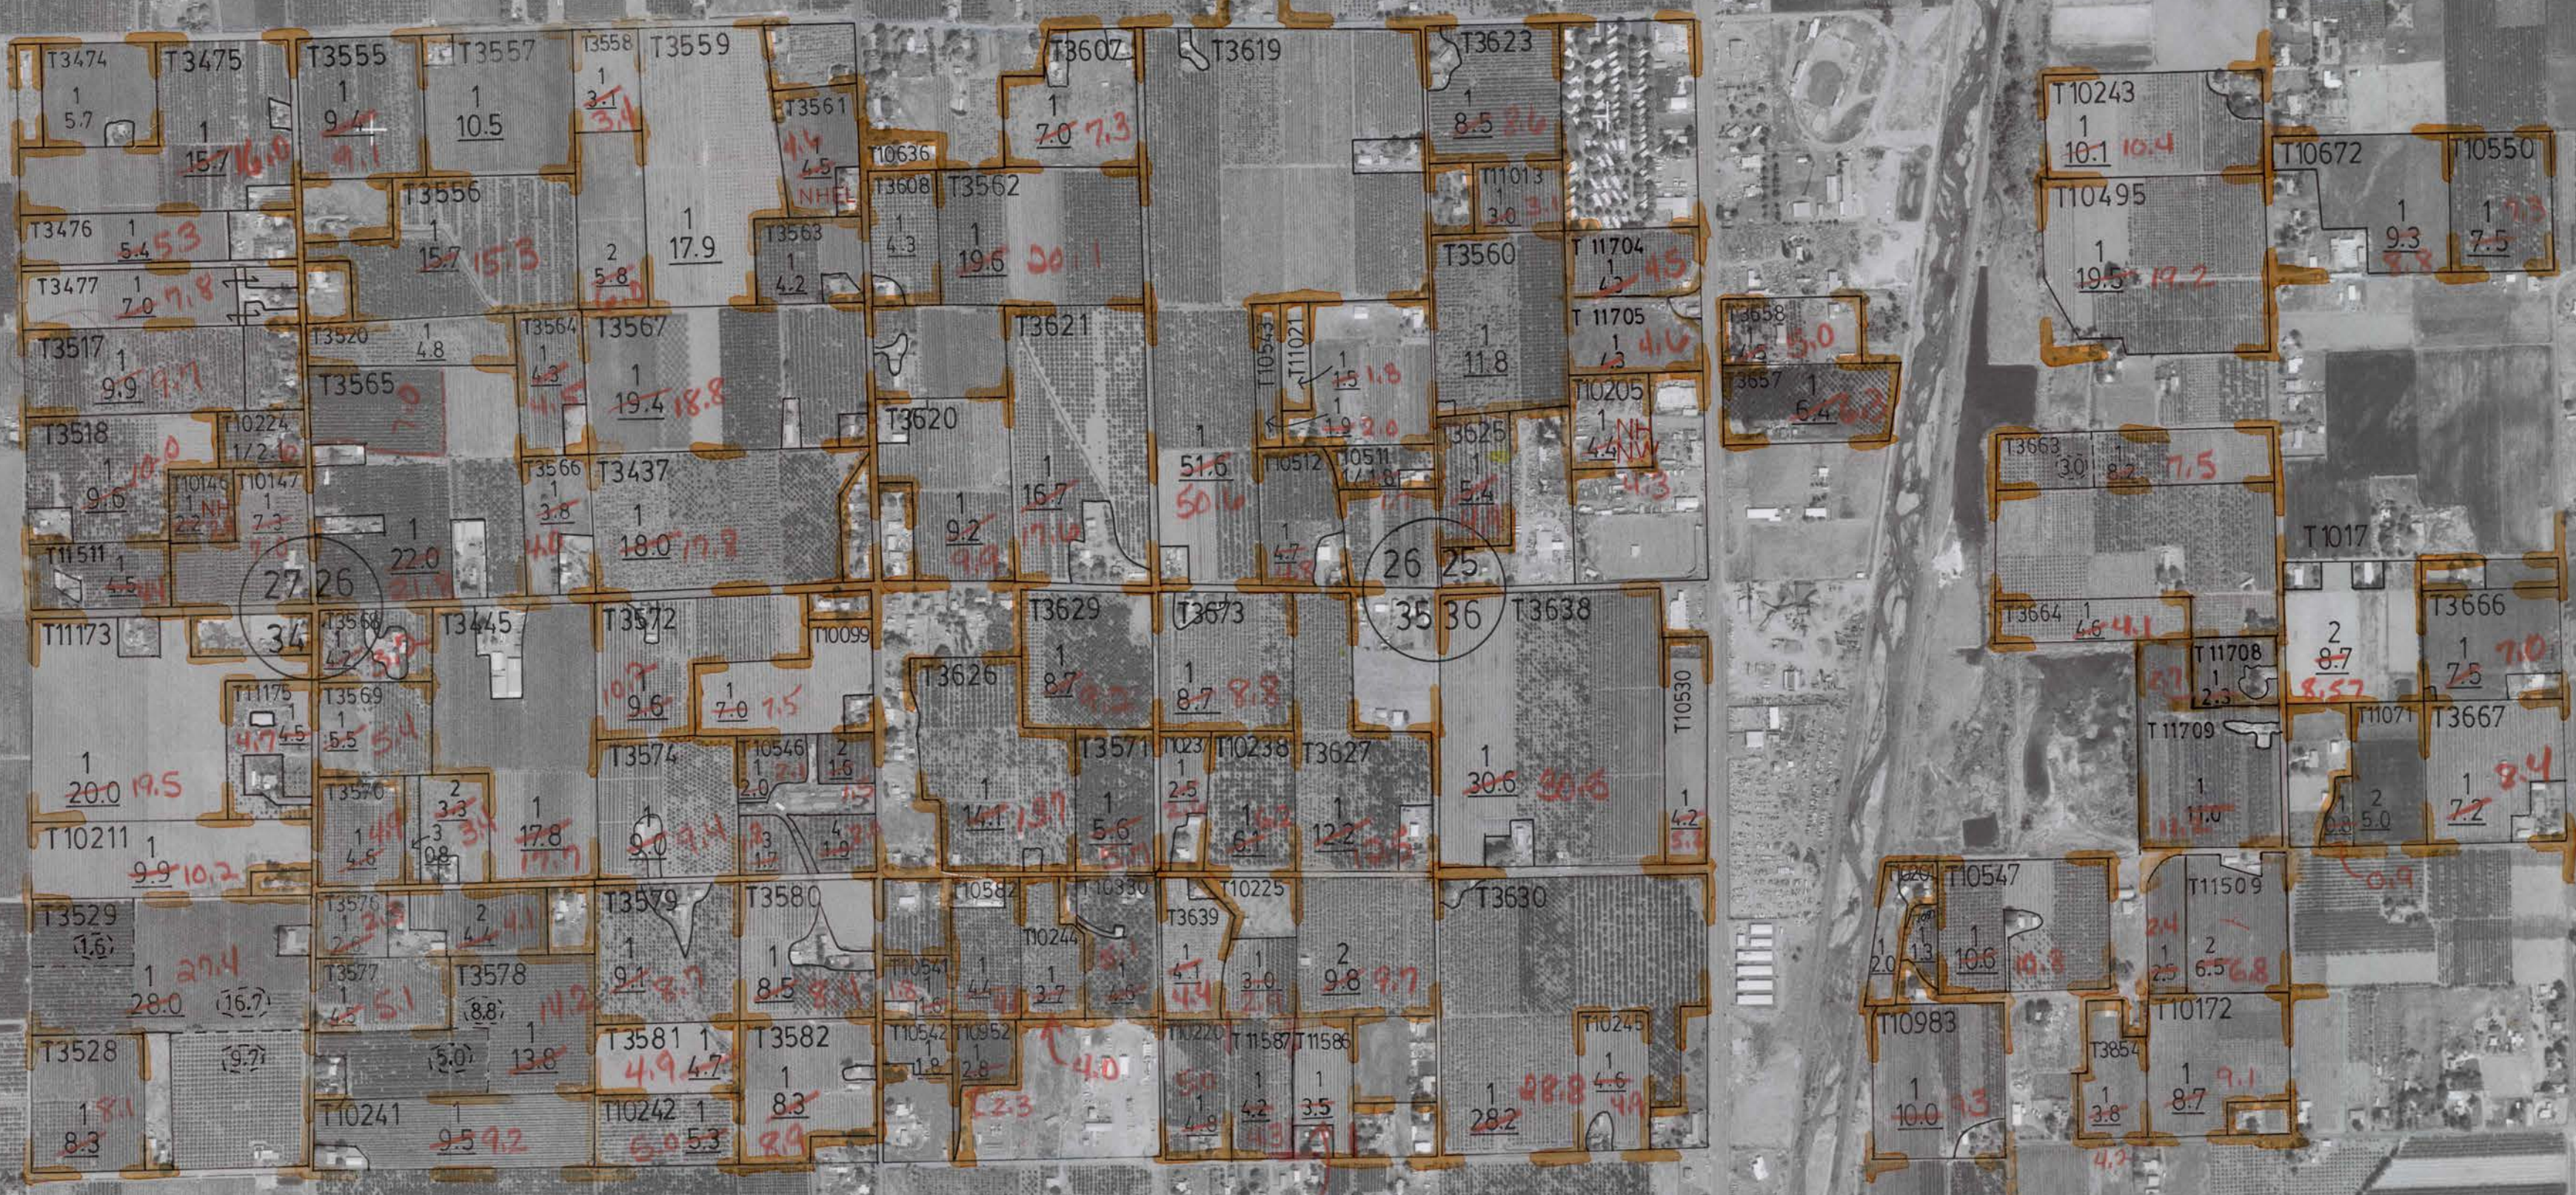

34 35
3 2

35 36
2 1