


232 L I²

27 F - 2

F 24

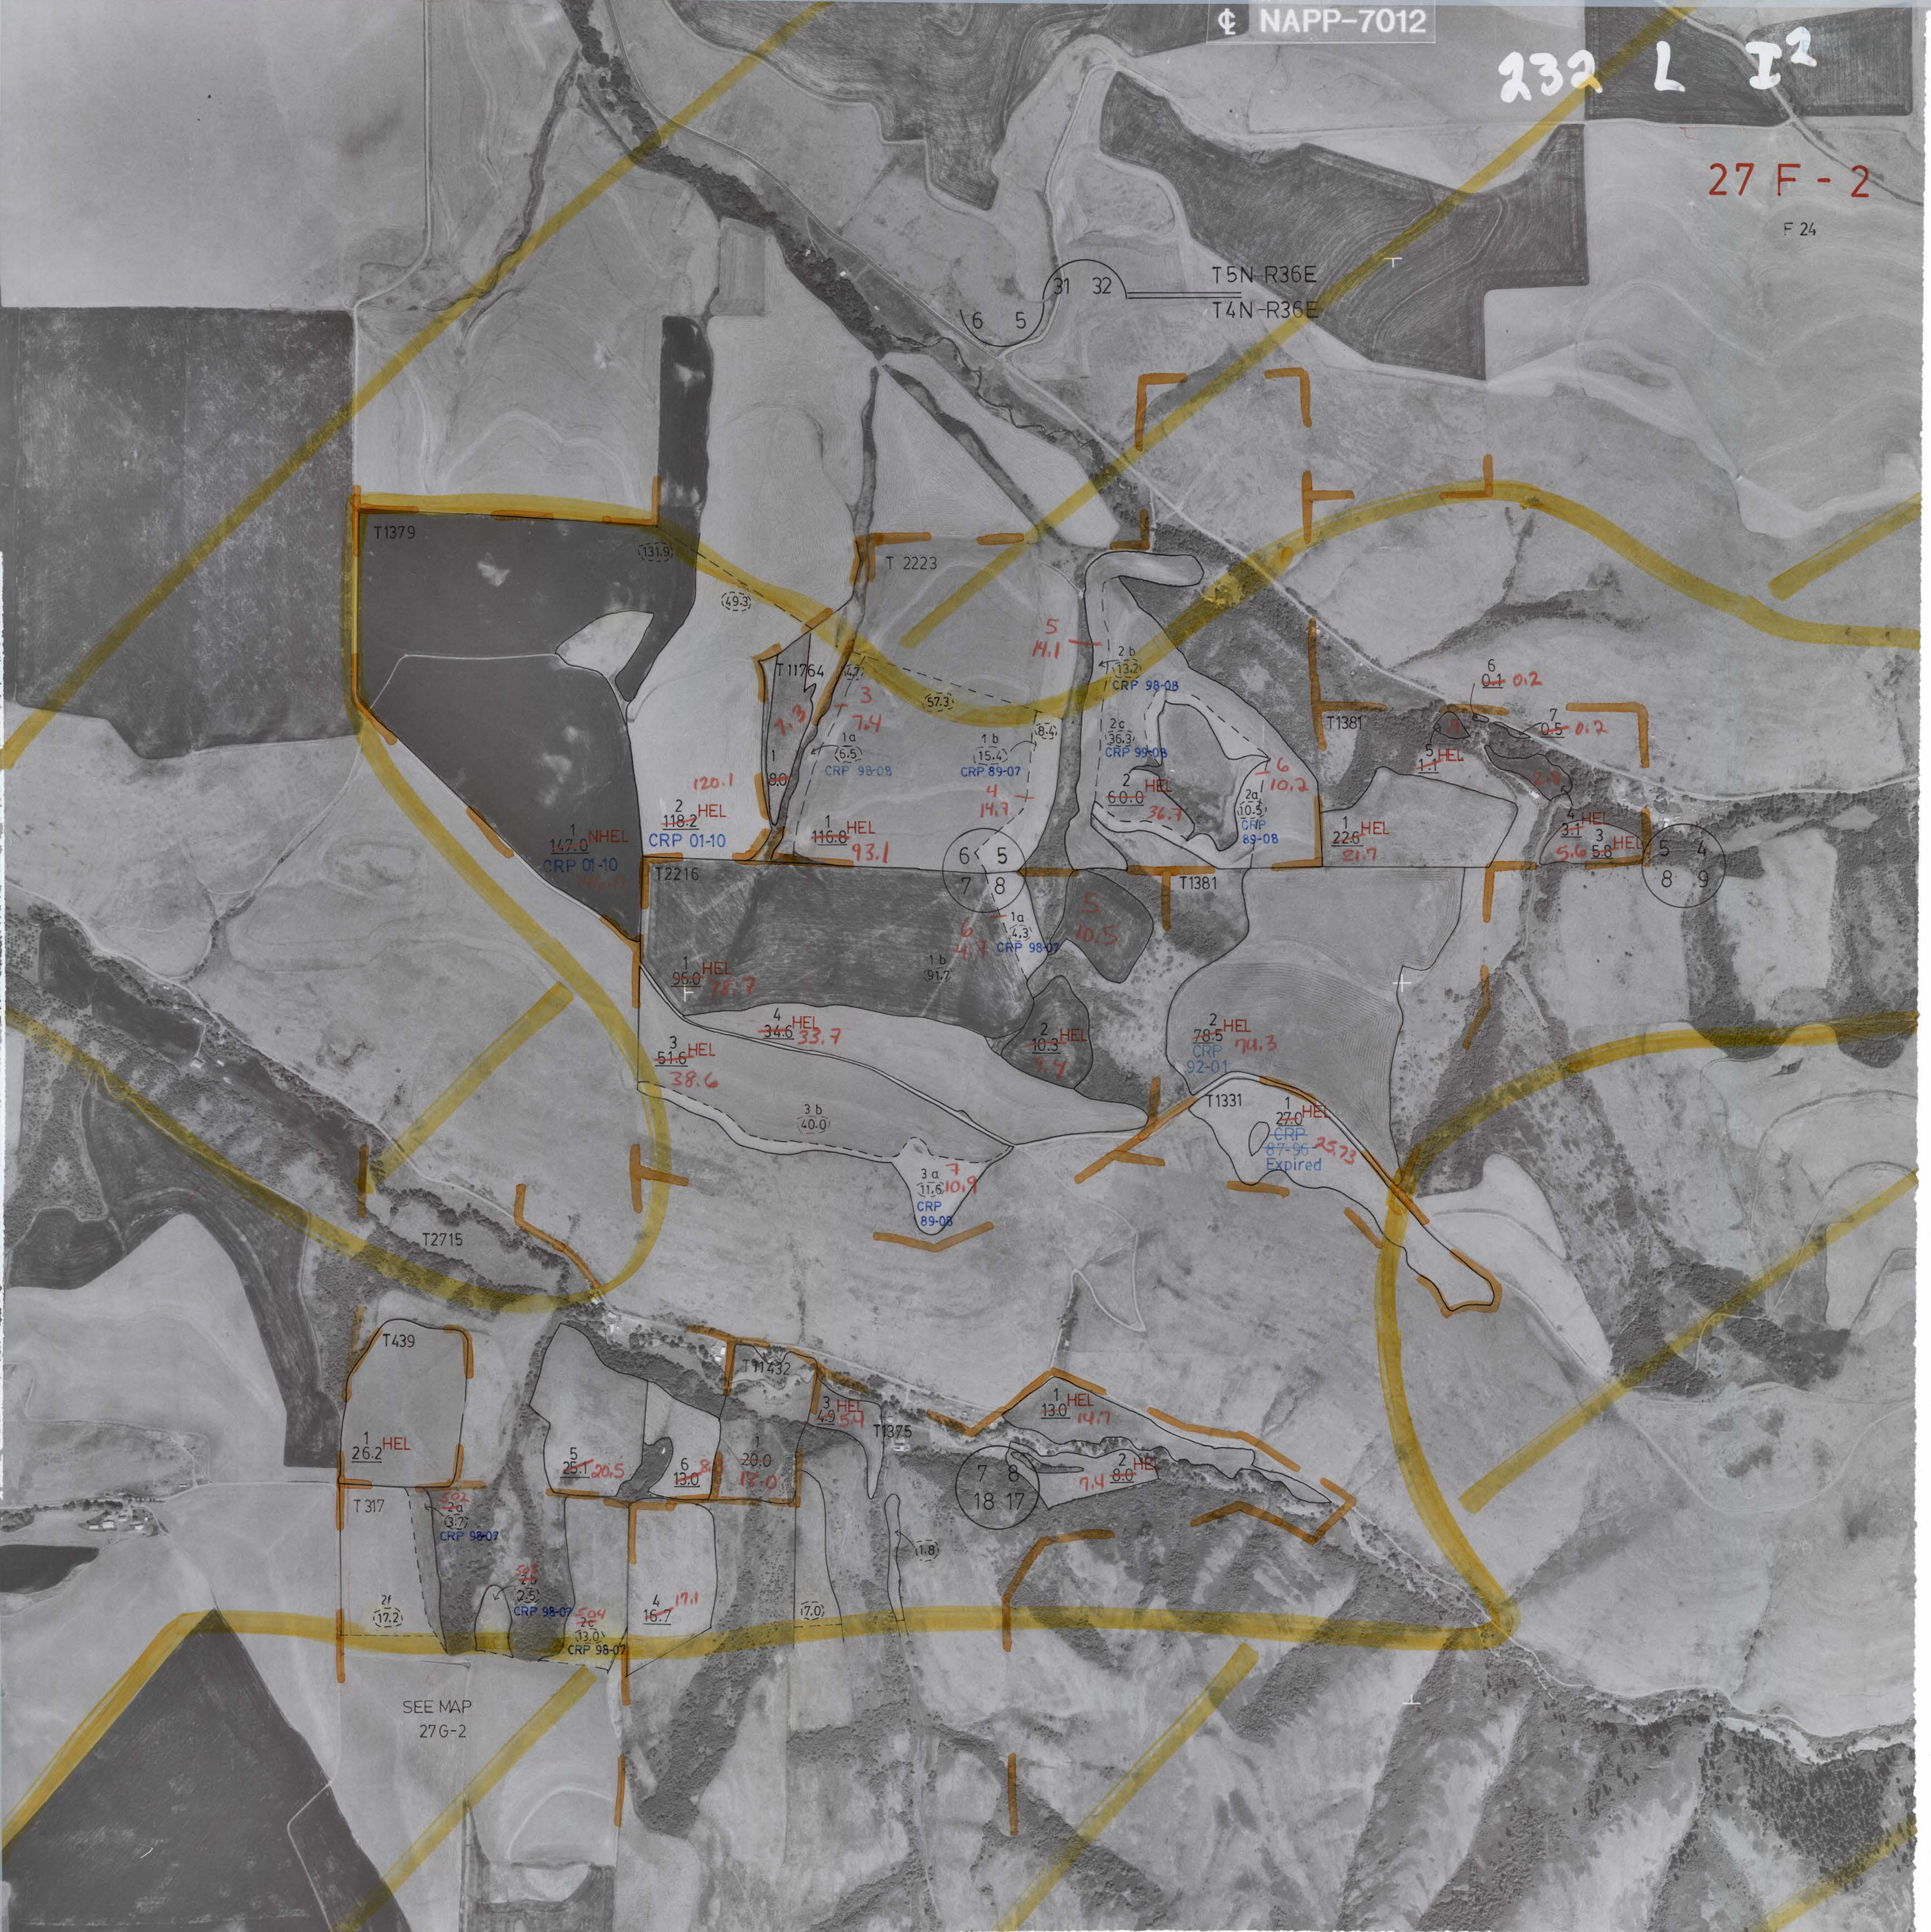

SEE MAP 27G-2