


6 D
D5

SEE MAP
6C

T5N-R29E

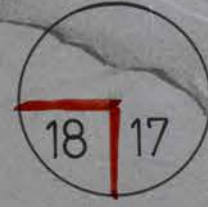

T 11456

SEE MAP
5D



T 11456




T 11544



SEE MAP
7D

T 11543

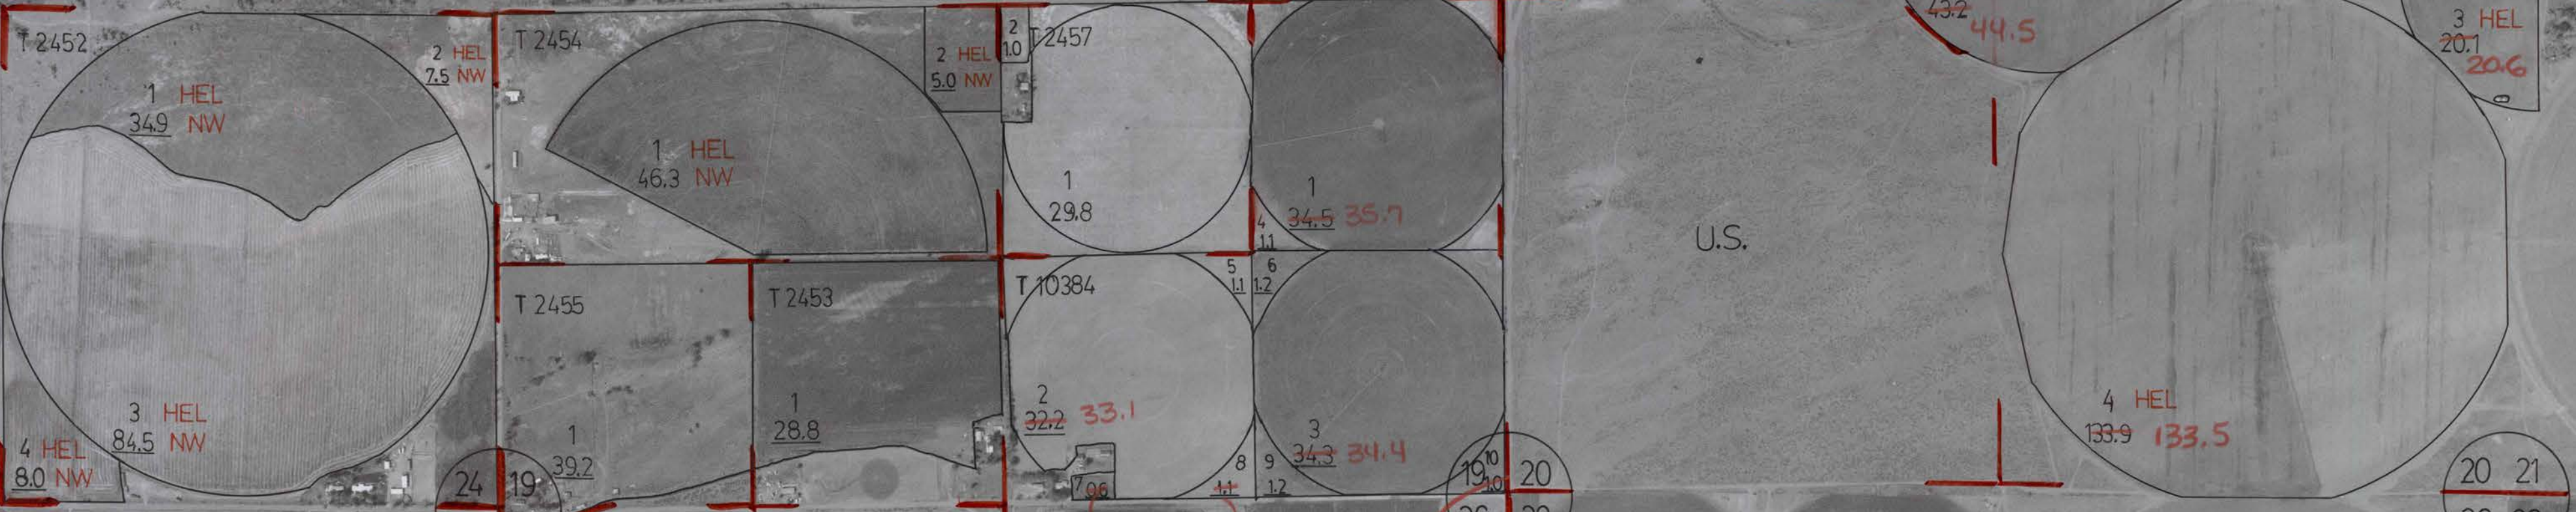

SEE MAP
6E