


CHAINED SCALE
10,574

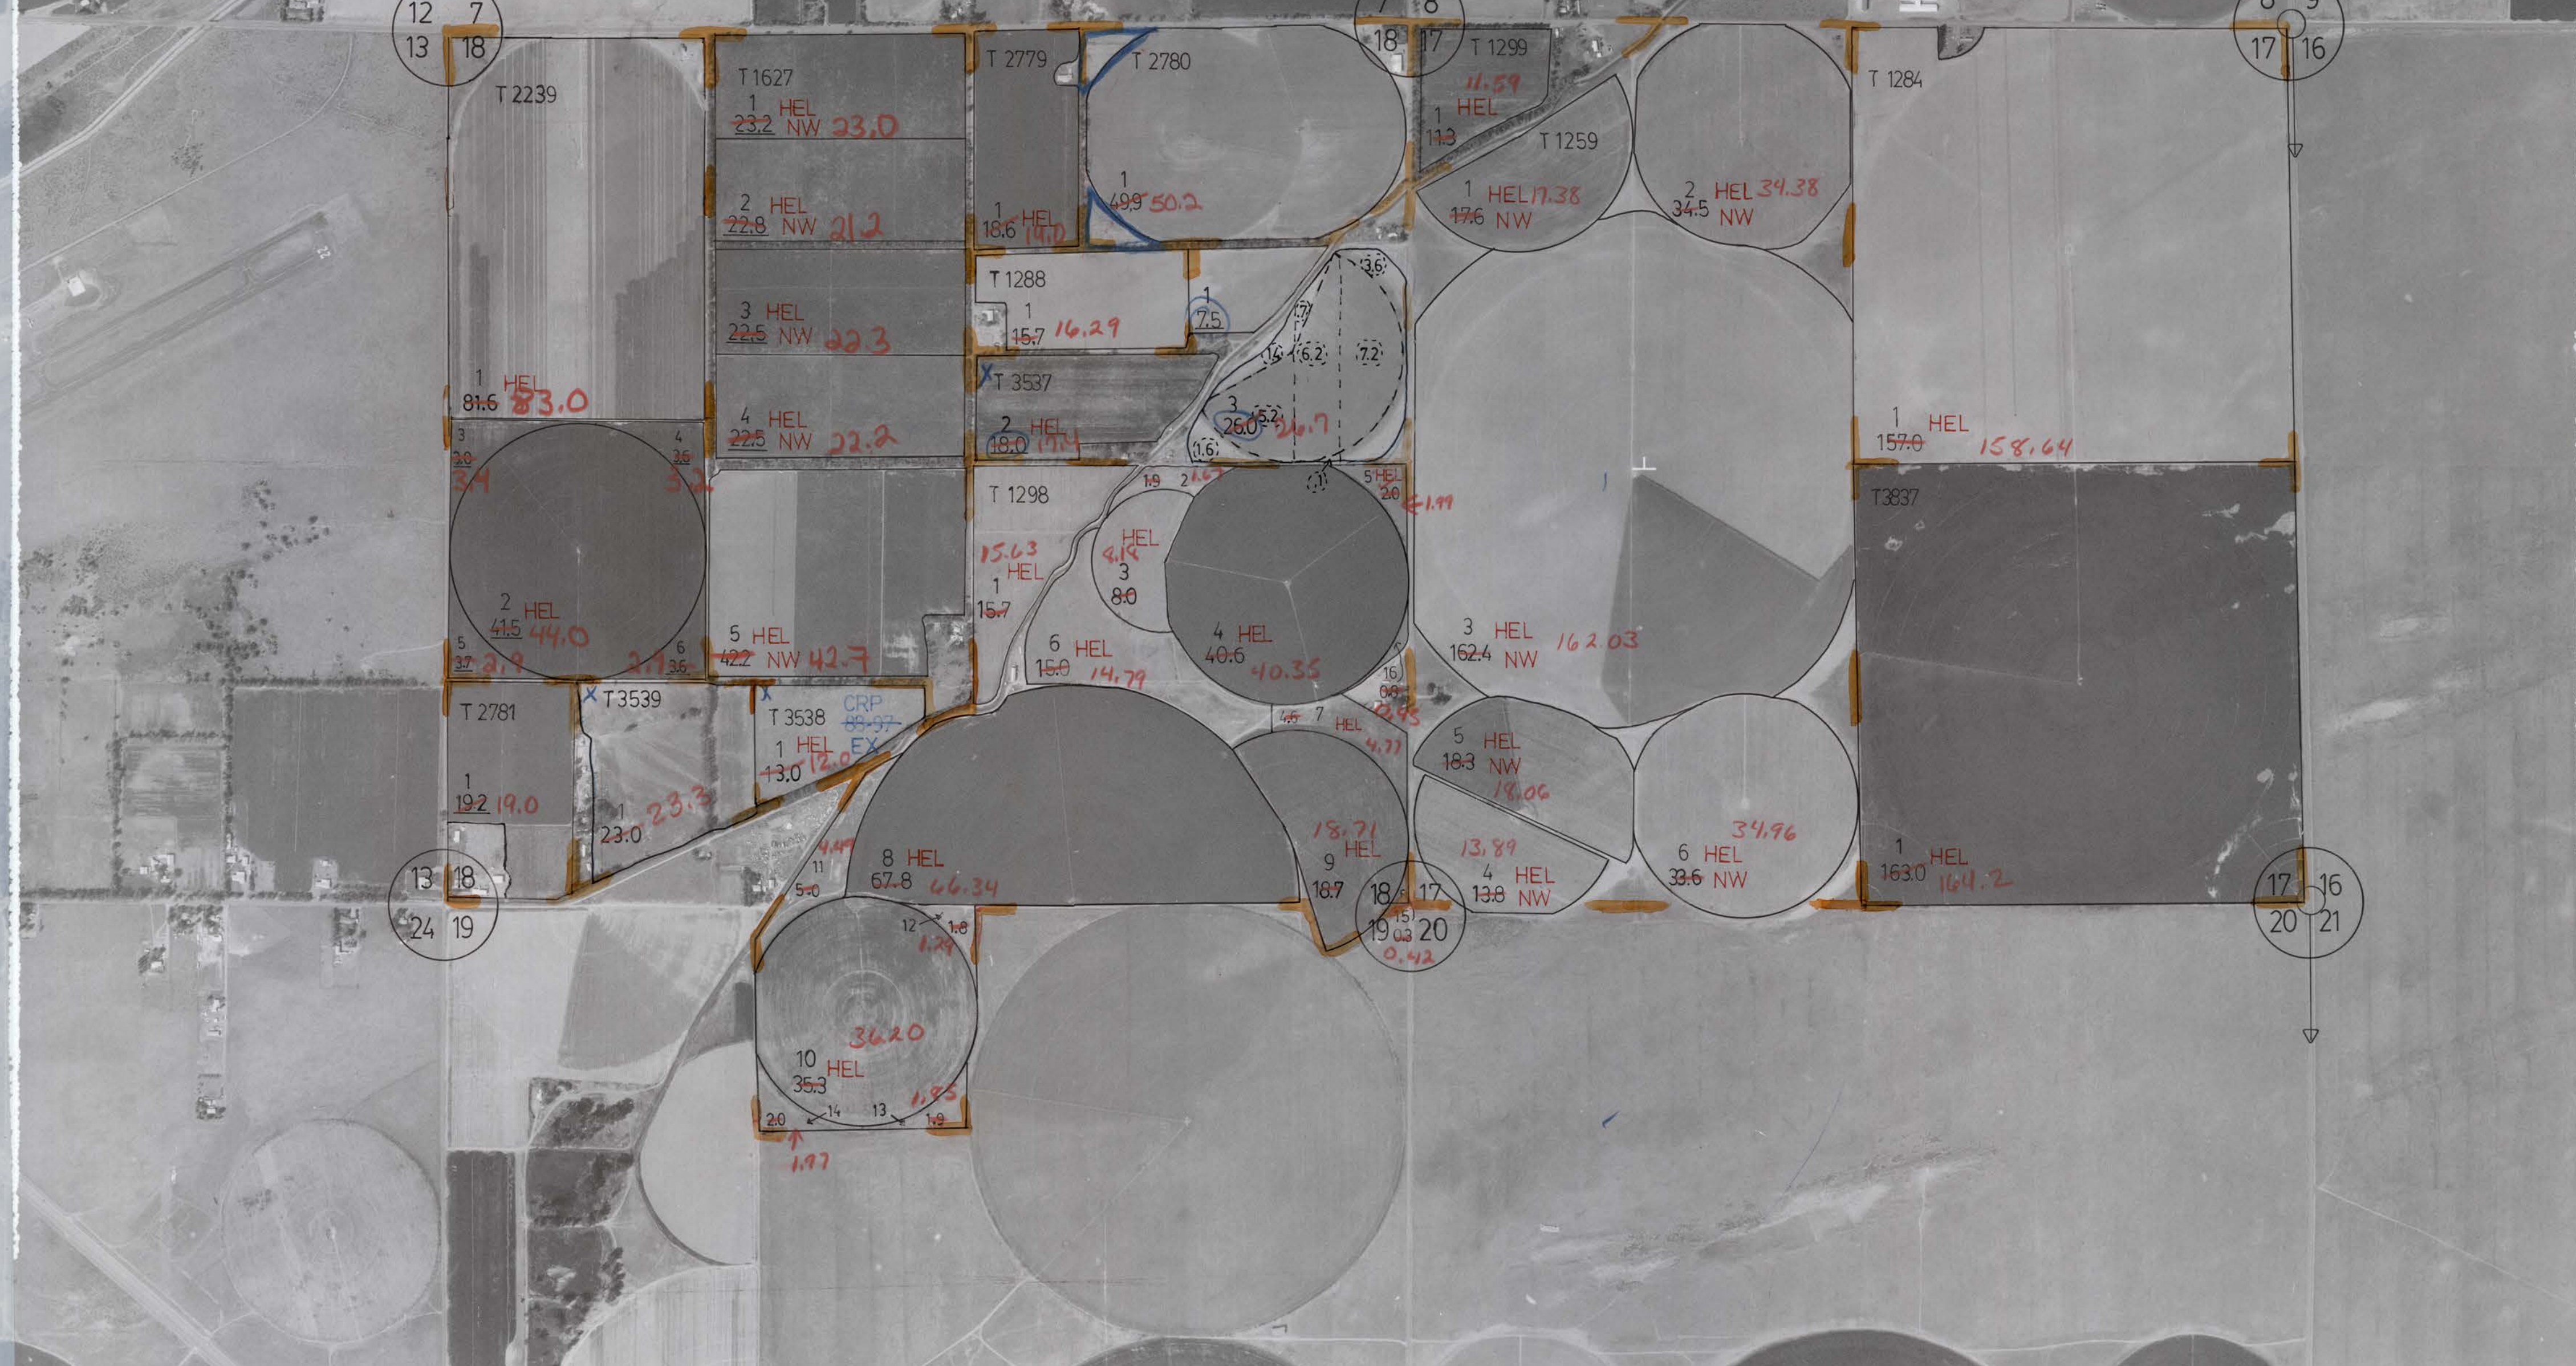

12 7

7 8

8 9

T4N-R28E

T4N-R29E

12 7
13 18

7 8
18 17

8 9
17 16

T 2239

T 1627

T 2779

T 2780

T 1299

T 1284

1 HEL
23.2 NW 23.0

11.59
HEL

2 HEL
22.8 NW 21.2

1 HEL
18.6 NW 14.0

1
49.9 50.2

1 HEL 17.38
17.6 NW

2 HEL 34.38
34.5 NW

3 HEL
22.5 NW 22.3

T 1288

1
15.7 16.29

1
7.5

T 3537

2 HEL
18.0 NW 17.1

3
25.0 26.7

1 HEL
157.0 158.64

1 HEL
81.6 83.0

3
34

4
3.2

2 HEL
41.5 44.0

5
37 2.9

5 HEL
42.2 NW 42.7

HEL
3
8.0

4 HEL
40.6 40.35

3 HEL
162.4 NW 162.03

T 2781

T 3539

T 3538

CRP
EX

1
19.2 19.0

1
23.0

1 HEL
13.0 12.0

8 HEL
67.8 66.34

HEL
9
18.71

18.7

5 HEL
18.3 NW 18.06

3 HEL
13.89

4 HEL
13.8 NW

6 HEL
34.96
33.6 NW

1 HEL
163.0 164.2

13 18
24 19

18 17
19 20

17 16
20 21

10 HEL
35.3 36.20

2.0 1.4 1.3 1.0

1.97