

T5N-R29E

T 11544

U.S.

17 16
20 21

15 14
22 23

SEE MAP
6D
T 11543

T 1909








T 10390

T 2458

20 21
29 28

21 22
28 27

22 23
27 26

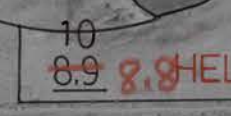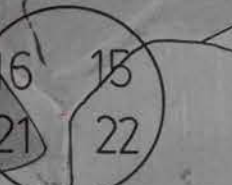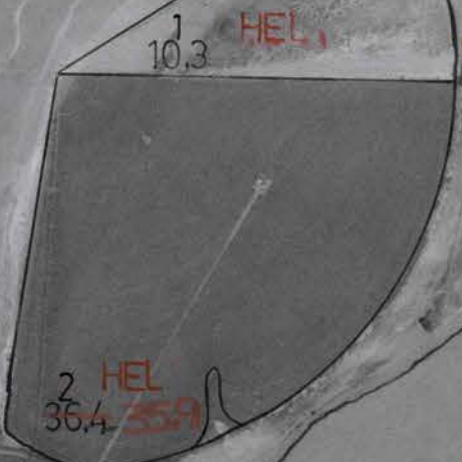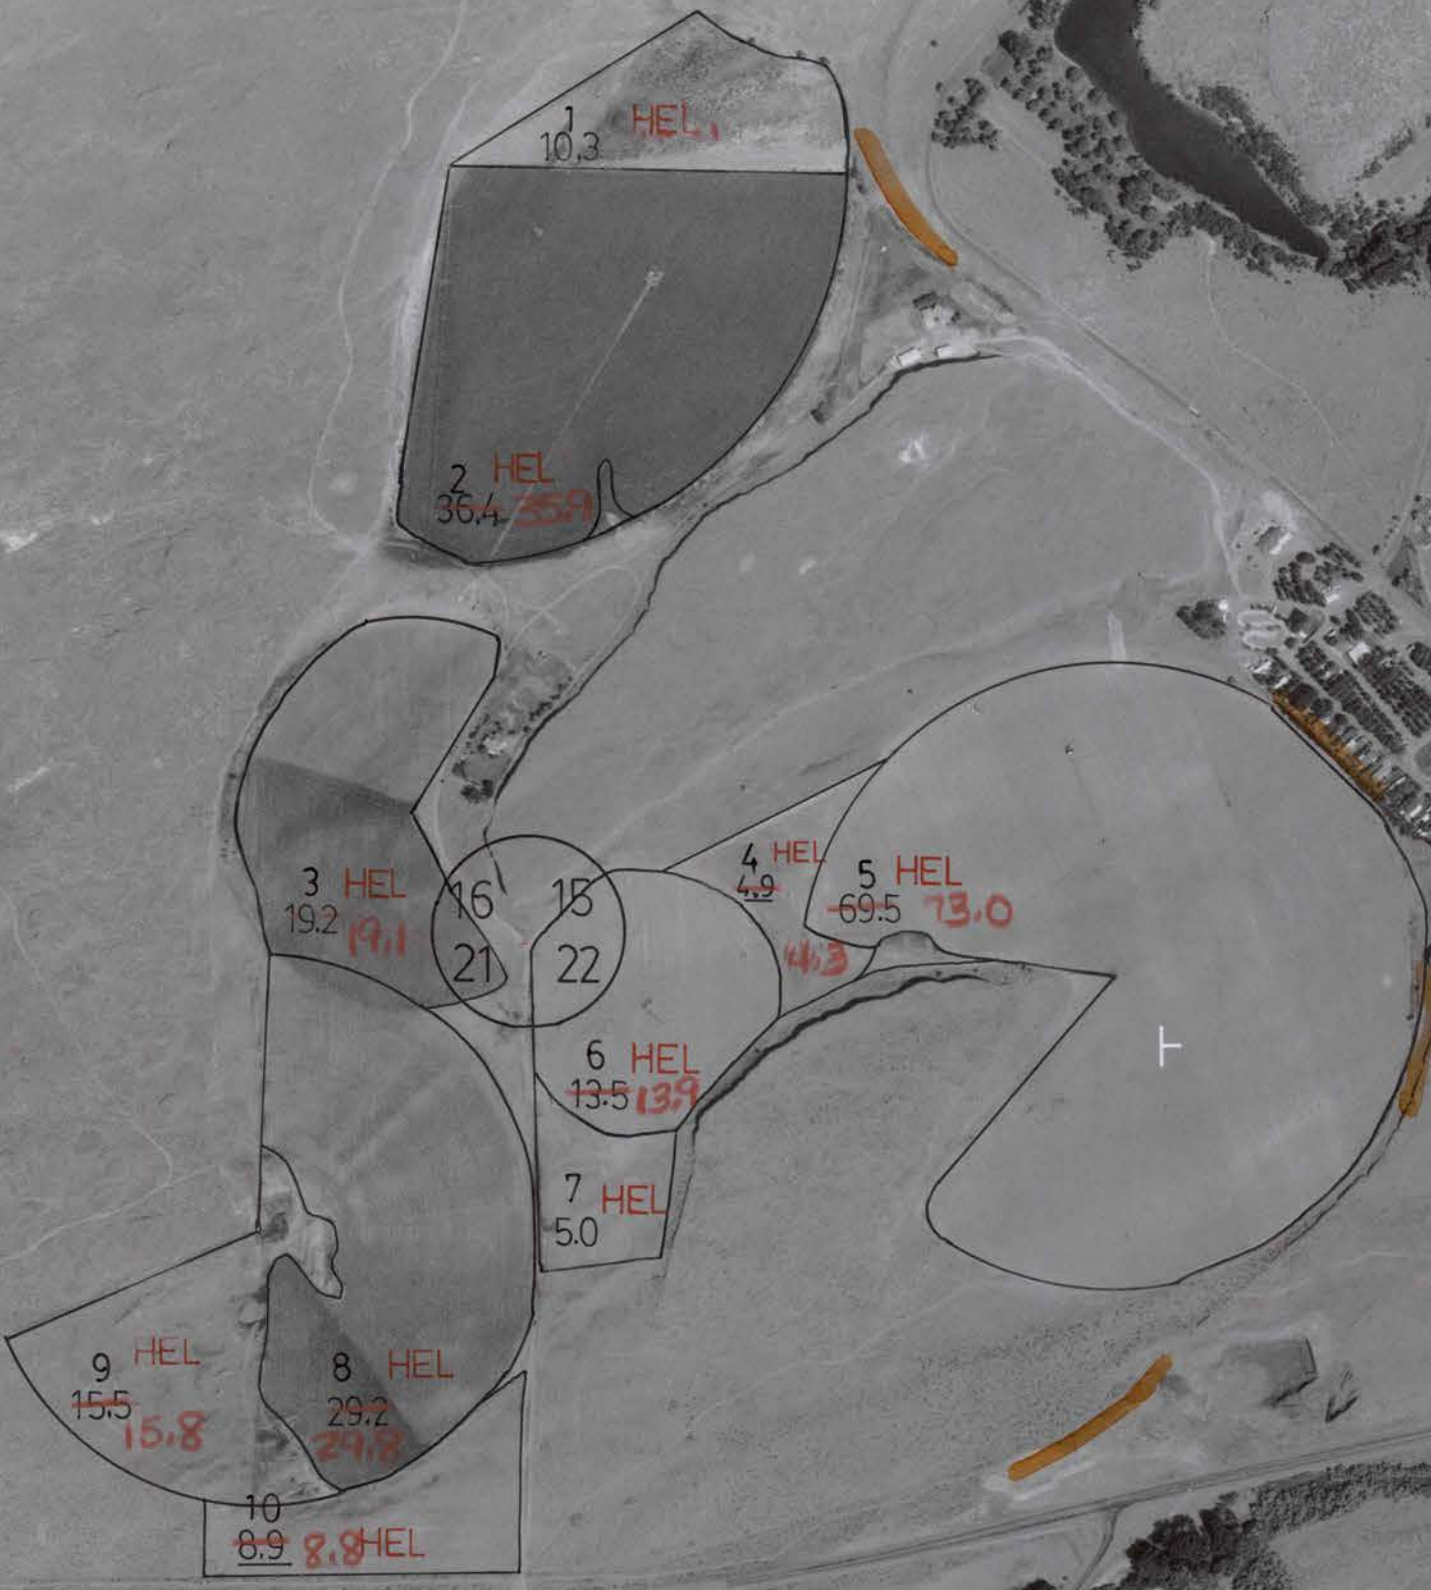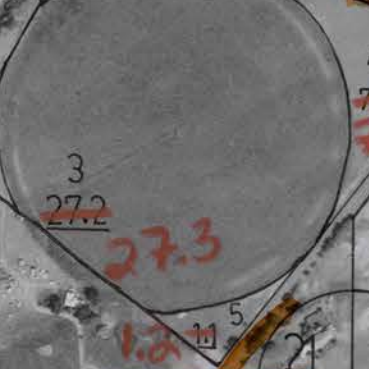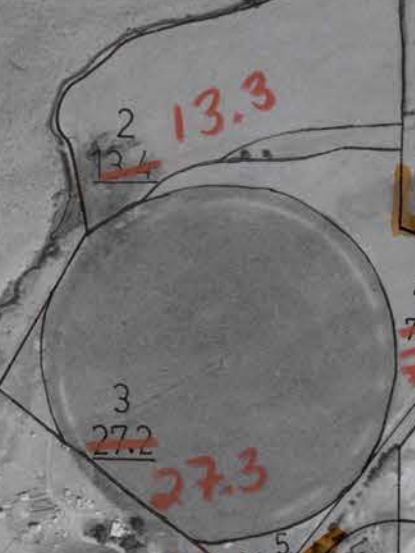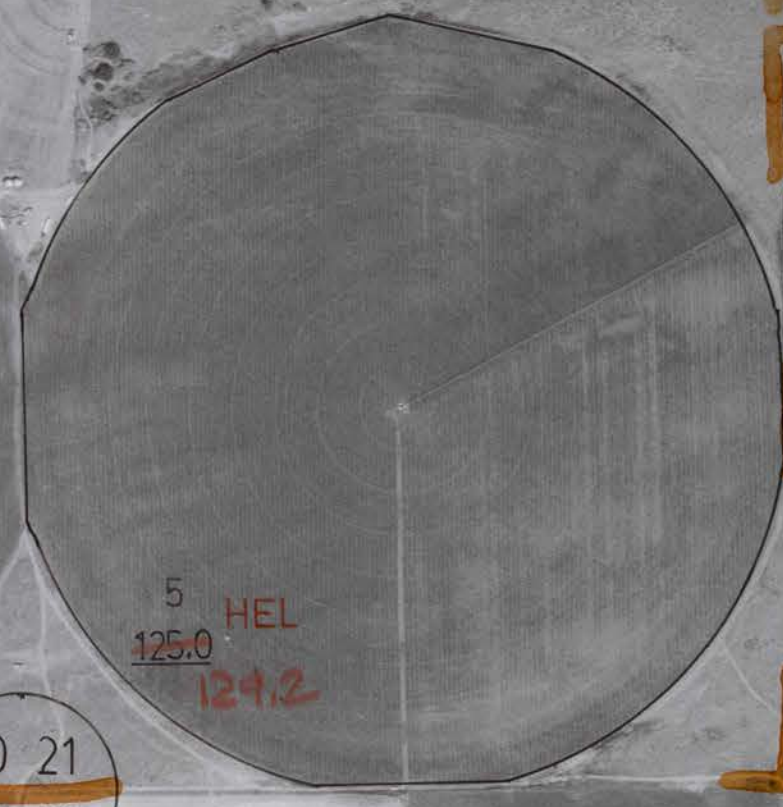

T1629