


6R Hi

8D-1

D7

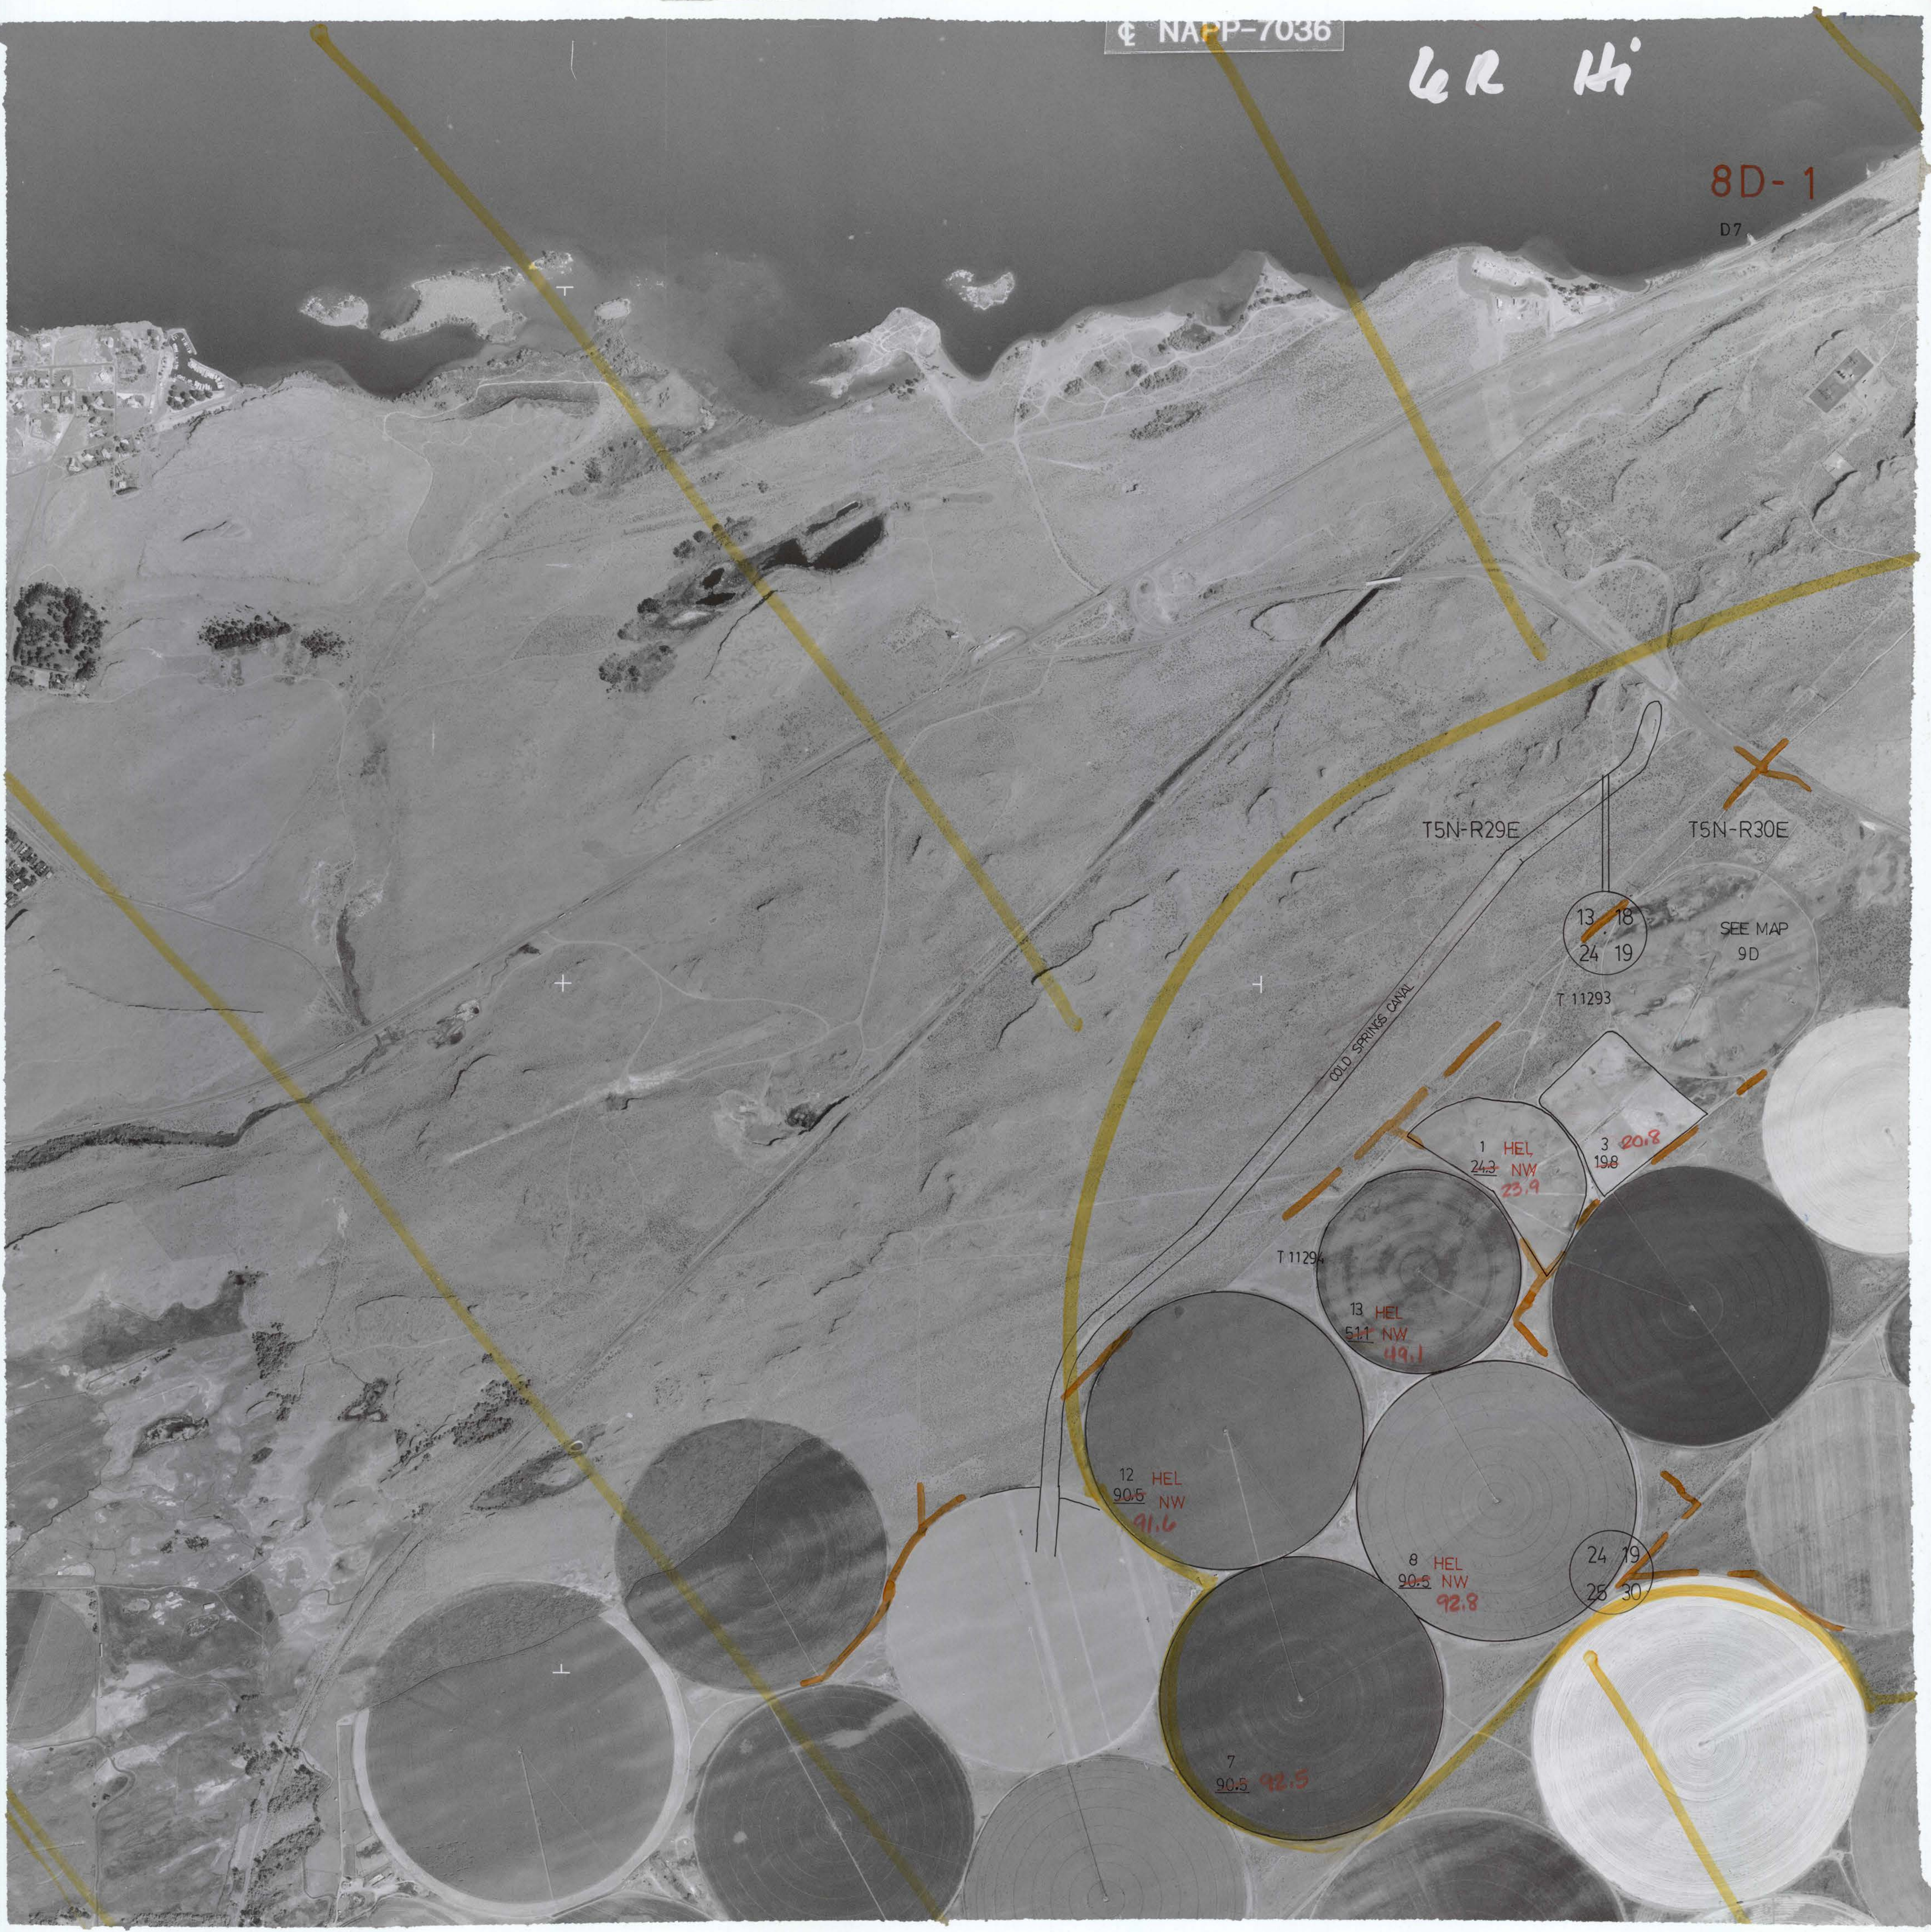

T5N-R29E

T5N-R30E

13 18
24 19

SEE MAP
9D

T 11293

OLD SPRINGS CANAL

1 HEL
24.3 NW
23.9

3 20.8
19.8

T 11294

13 HEL
51.1 NW
49.1

12 HEL
90.5 NW
91.6

8 HEL
90.5 NW
92.8

24 19
25 30

7
90.5 92.5