


D 8

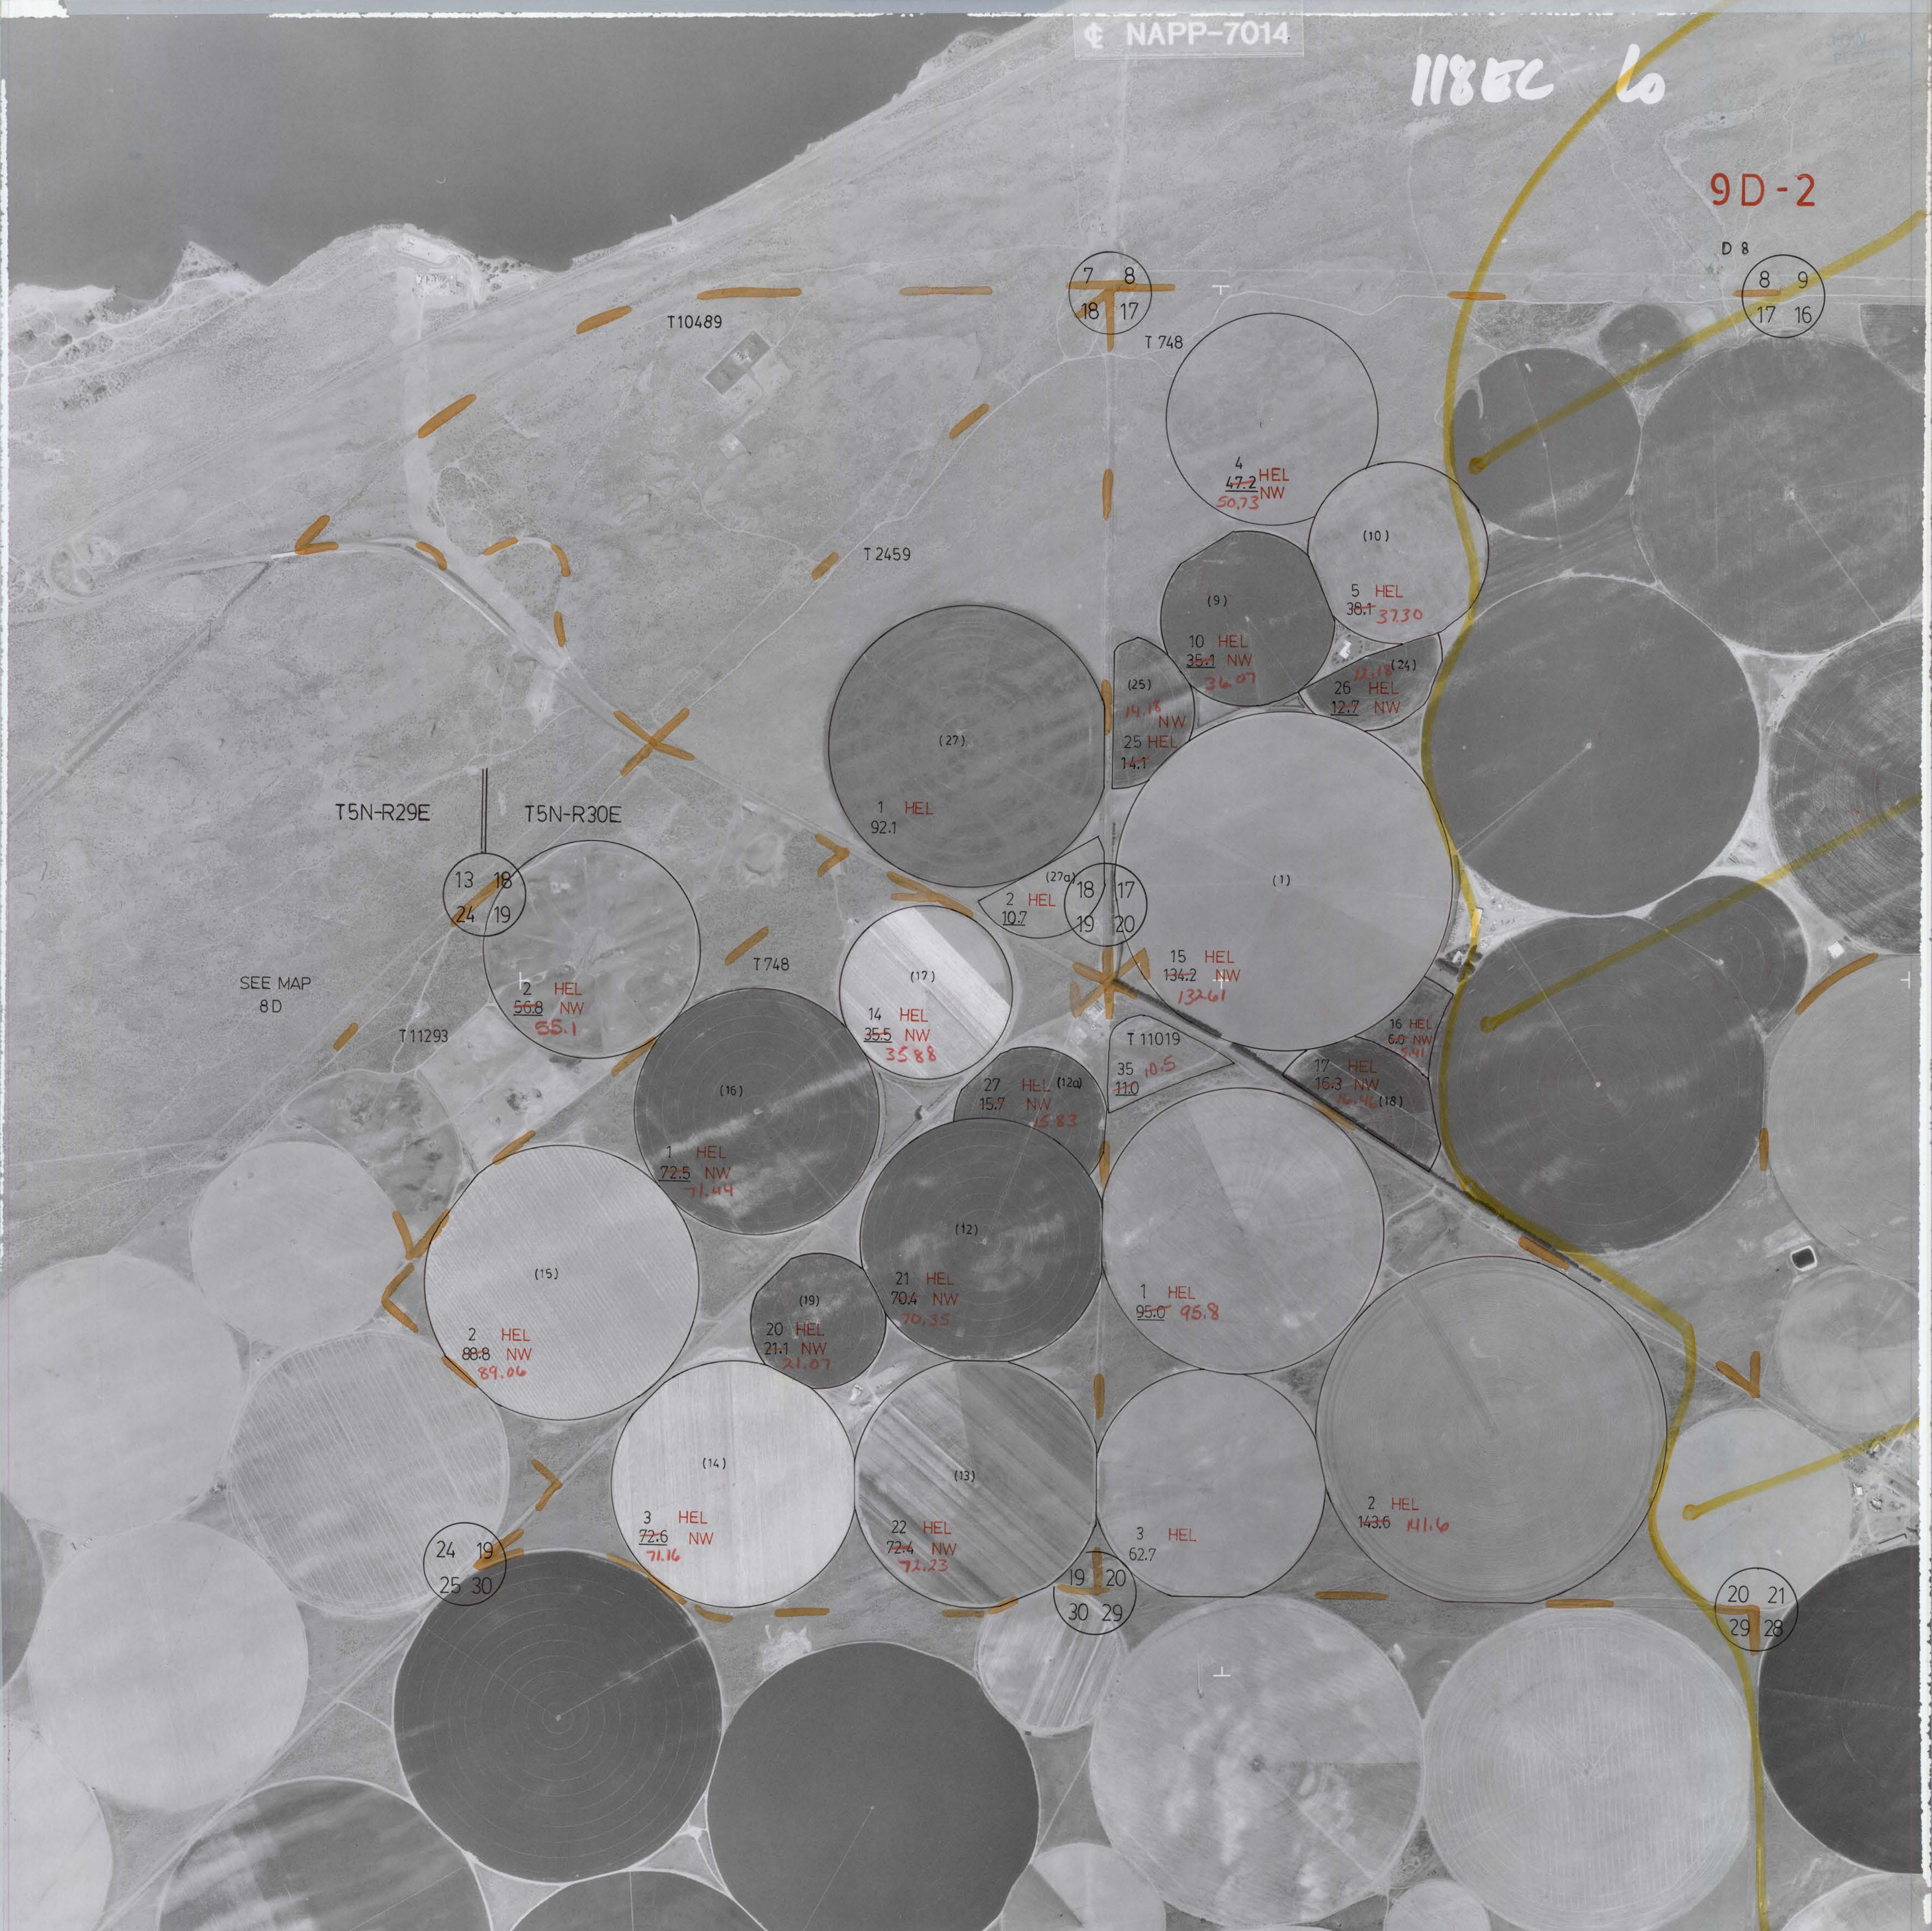

7 8
18 17

8 9
17 16

13 18
24 19

18 17
19 20

24 19
25 30

19 20
30 29

20 21
29 28

T10489

T 748

T 2459

T5N-R29E

T5N-R30E

T 748

T 11293

T 11019

SEE MAP 8D

4 HEL
47.2 NW
50.73

(10)

5 HEL
38.1 NW
37.30

10 HEL
35.1 NW
36.07

26 HEL
12.7 NW

(27)

1 HEL
92.1

25 HEL
14.7 NW

(1)

15 HEL
134.2 NW
132.61

(17)

14 HEL
35.5 NW
35.88

27 HEL (12a)
15.7 NW
15.83

17 HEL
16.3 NW
16.46 (18)

(16)

1 HEL
72.5 NW
71.44

(12)

21 HEL
70.4 NW
70.35

1 HEL
95.0 NW
95.8

(15)

2 HEL
88.8 NW
89.06

(19)

20 HEL
21.1 NW
21.07

(14)

3 HEL
72.6 NW
71.16

(13)

22 HEL
72.4 NW
72.23

3 HEL
62.7

2 HEL
143.6 NW
141.6