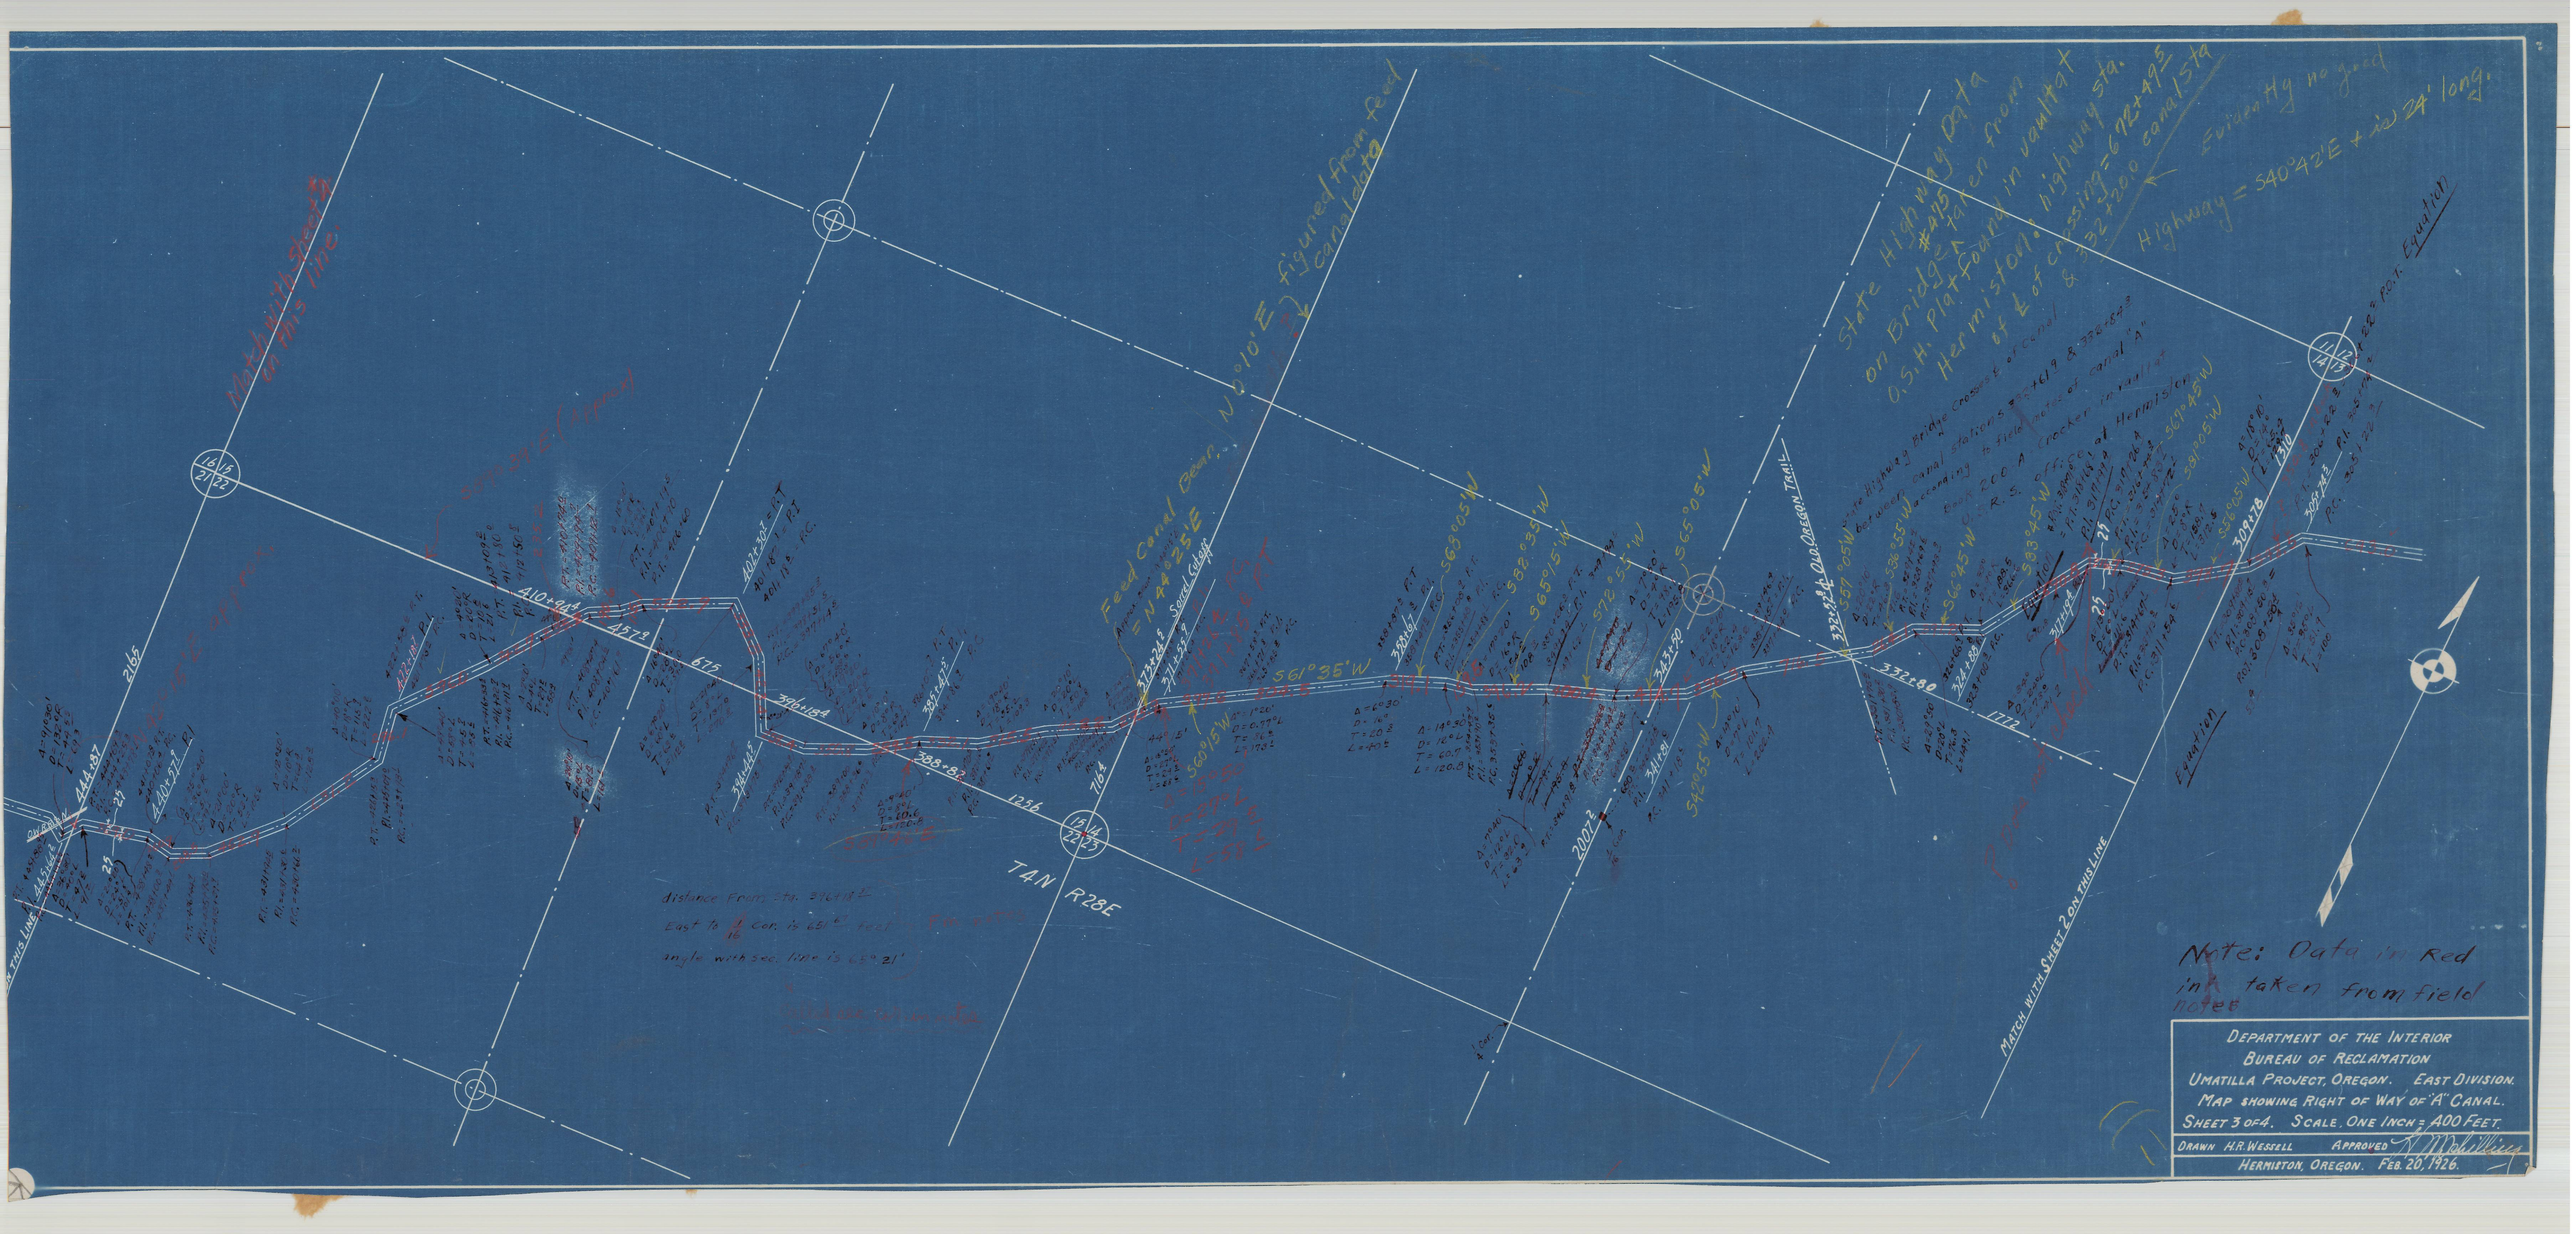

Match with Sheet 3 on this line.
Feed Canal Bear N 0°10' E figured from feed canal data
State Highway Data on Bridge #475 taken from O.S.H. Platfound in vault at Hermiston. highway sta. of ℄ of crossing = 692+49.5 & 332+20.0 canal sta
Highway = S40°42'E + is 24' long.
Evidently no grad
S61°35'W
S63°05'W
S65°05'W
S42°55'W
T4N R28E
Old Oregon Trail
Equation
Match with Sheet 2 on this line
distance from sta. 396+18.2
East to 1/16 Cor. is 651.6' feet
angle with sec. line is 65°21'
Note: Data in Red ink taken from field notes
DEPARTMENT OF THE INTERIOR
BUREAU OF RECLAMATION
UMATILLA PROJECT, OREGON. EAST DIVISION.
MAP SHOWING RIGHT OF WAY OF "A" CANAL.
SHEET 3 OF 4. SCALE, ONE INCH = 400 FEET.
DRAWN H.R. WESSELL APPROVED
HERMISTON, OREGON. FEB. 20, 1926.