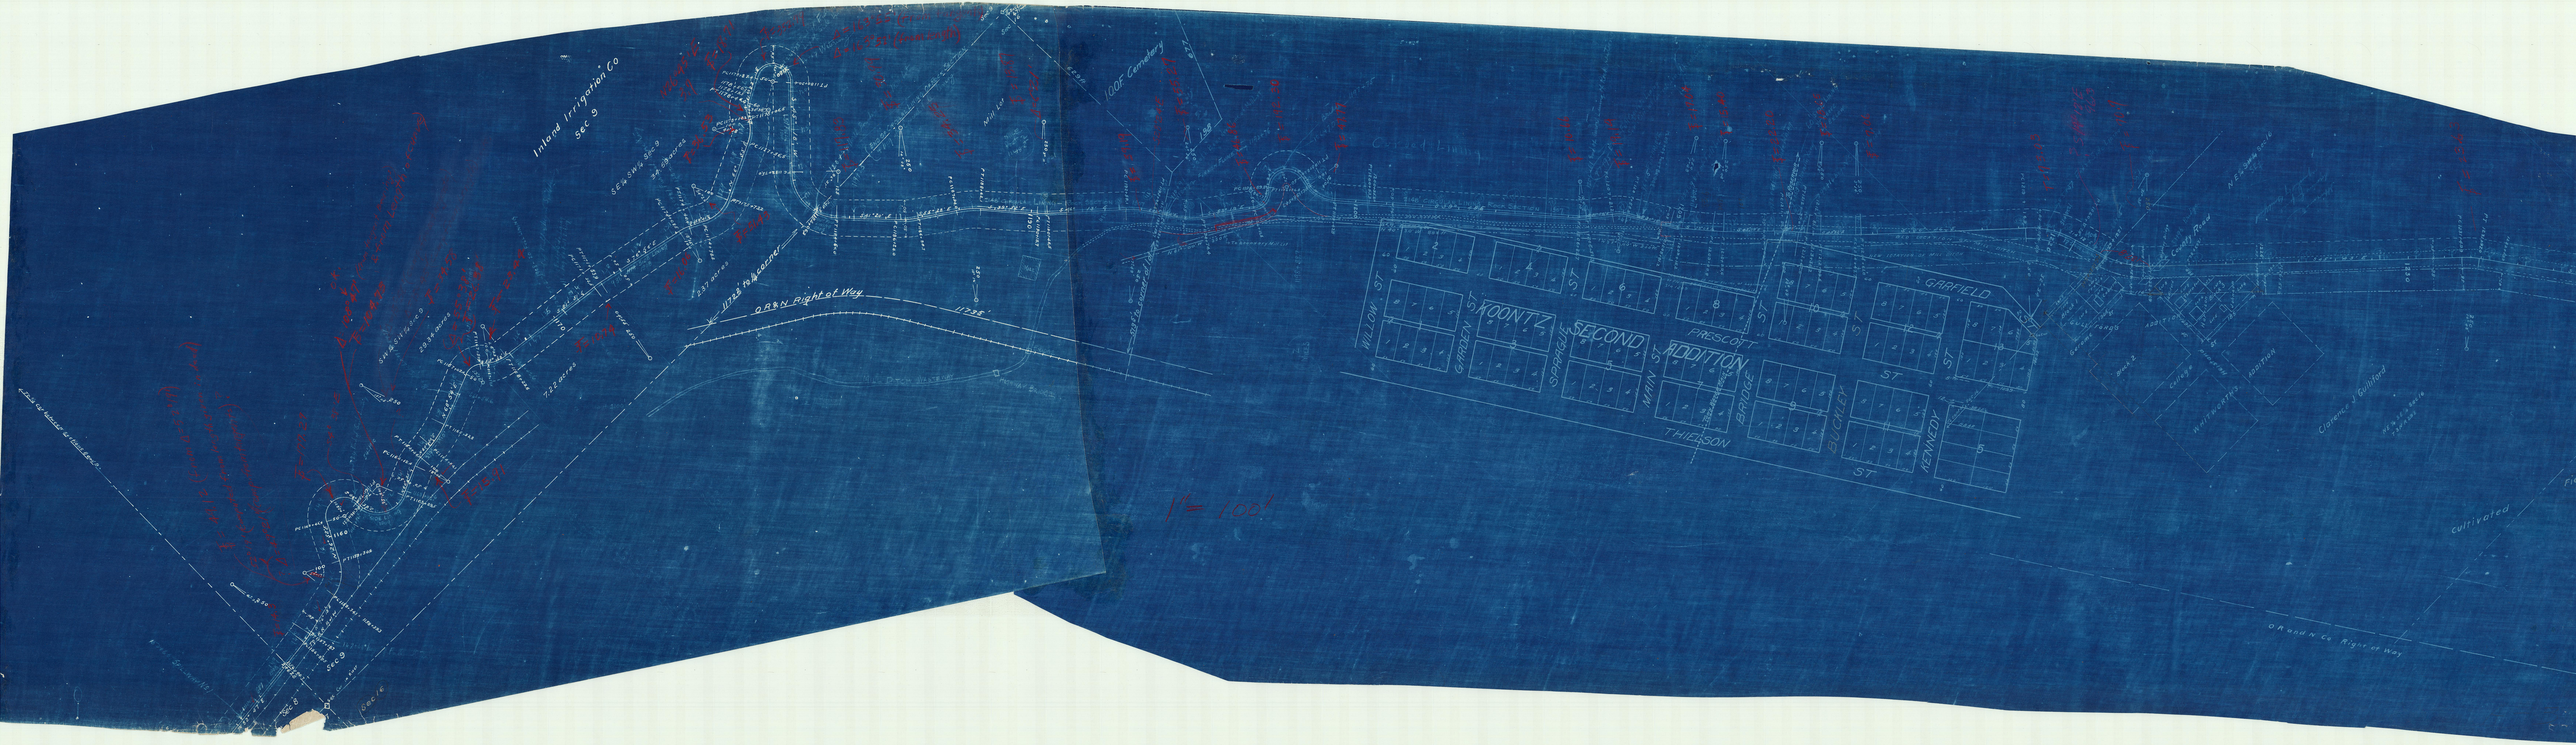
Inland Irrigation Co
Sec 9
Seasing Sec 9
Will Lee
Sec 10
Sec 9
Sec 16
