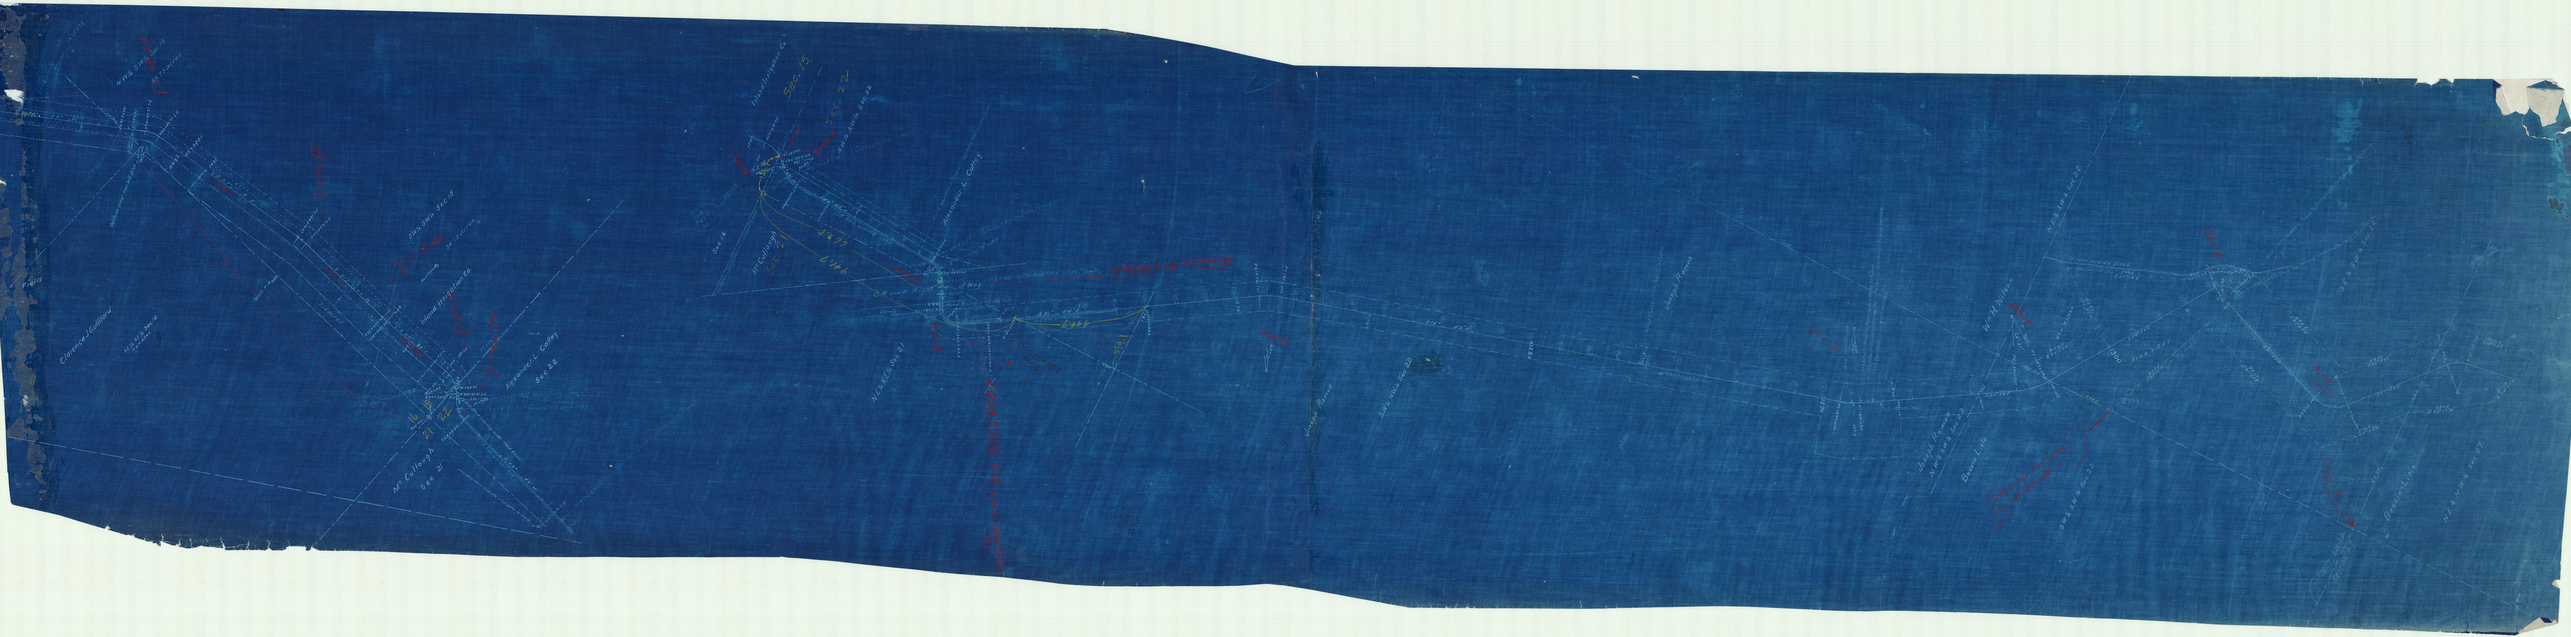
Sec 15
Sec 22
Sec 21
