


bk 2

15

18

HOME ADDITION
TO
ATHENA
UMATILLA COUNTY OREGON

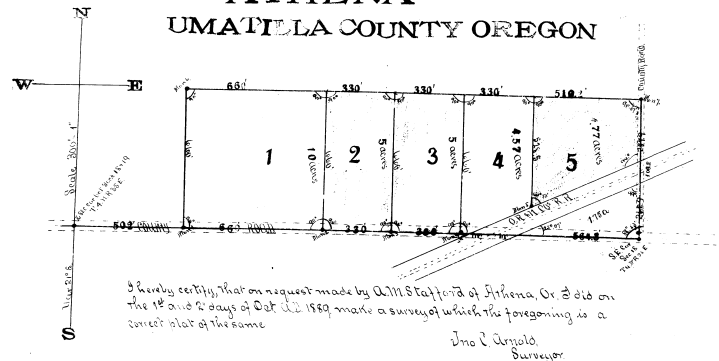

Filed Nov 2 1891 at 10 AM. R.M. Price Clerk