

(See Book 52-56  
58-59)

BK 2

p. 57

# Map of COLE'S ADDITION to the City of Pendleton, Or.

KNOW ALL MEN BY THESE PRESENTS-That we, F.G.Cole and Camilla A.Cole, his wife, of Pendleton, Umatilla County, Oregon, do here by dedicate to the use of the public all the streets and alleys in Cole's Addition to The City of Pendleton, Umatilla County, Oregon located in the southeast quarter of the southwest quarter of Section Three, Township Two, North of Range Thirty-two, R.W.M. in said Umatilla County, as shown by the plat of such addition hereto attached and made a part of this dedication.

IN WITNESS WHEREOF, we have hereunto set our hands and seals this 3rd day of April A.D. 1903  
Witnesses: F.G.Cole (Seal)  
Camilla A.Cole (Seal)


Maud L. Hailey  
STATE OF OREGON  
Umatilla County ) SS  
THIS CERTIFIES, That on this 3rd day of April, A.D. 1903, before me, the undersigned, a Notary Public in and for said County and State, personally appeared the above mentioned F.G.Cole and Camilla A.Cole, his wife, who are personally known to me to be the persons described in and who signed the foregoing dedication, and acknowledged to me that they executed the same freely and voluntarily for the uses and purposes therein mentioned.

IN WITNESS WHEREOF, I have hereunto set my hand and official seal this the day and year herein last above written.

T.G. Hailey  
Notary Public for Oregon, Residing at Pendleton.  
X T.G. HAILEY  
NOTARY PUBLIC  
STATE OF OREGON  
X

Filed for Record  
April 4, A.D. 1903 at  
11:55 o'clock A.M.

Wm. Tolson  
Recorder of  
Conveyances.

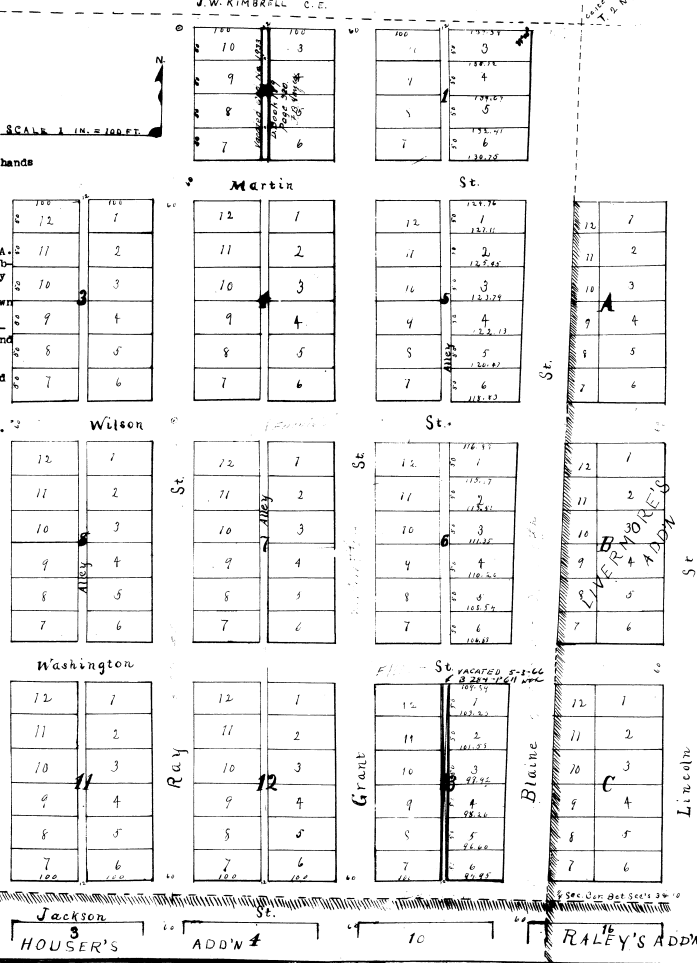

2 HOUSER'S 3 ADDN 4 10 RALEY'S ADDN