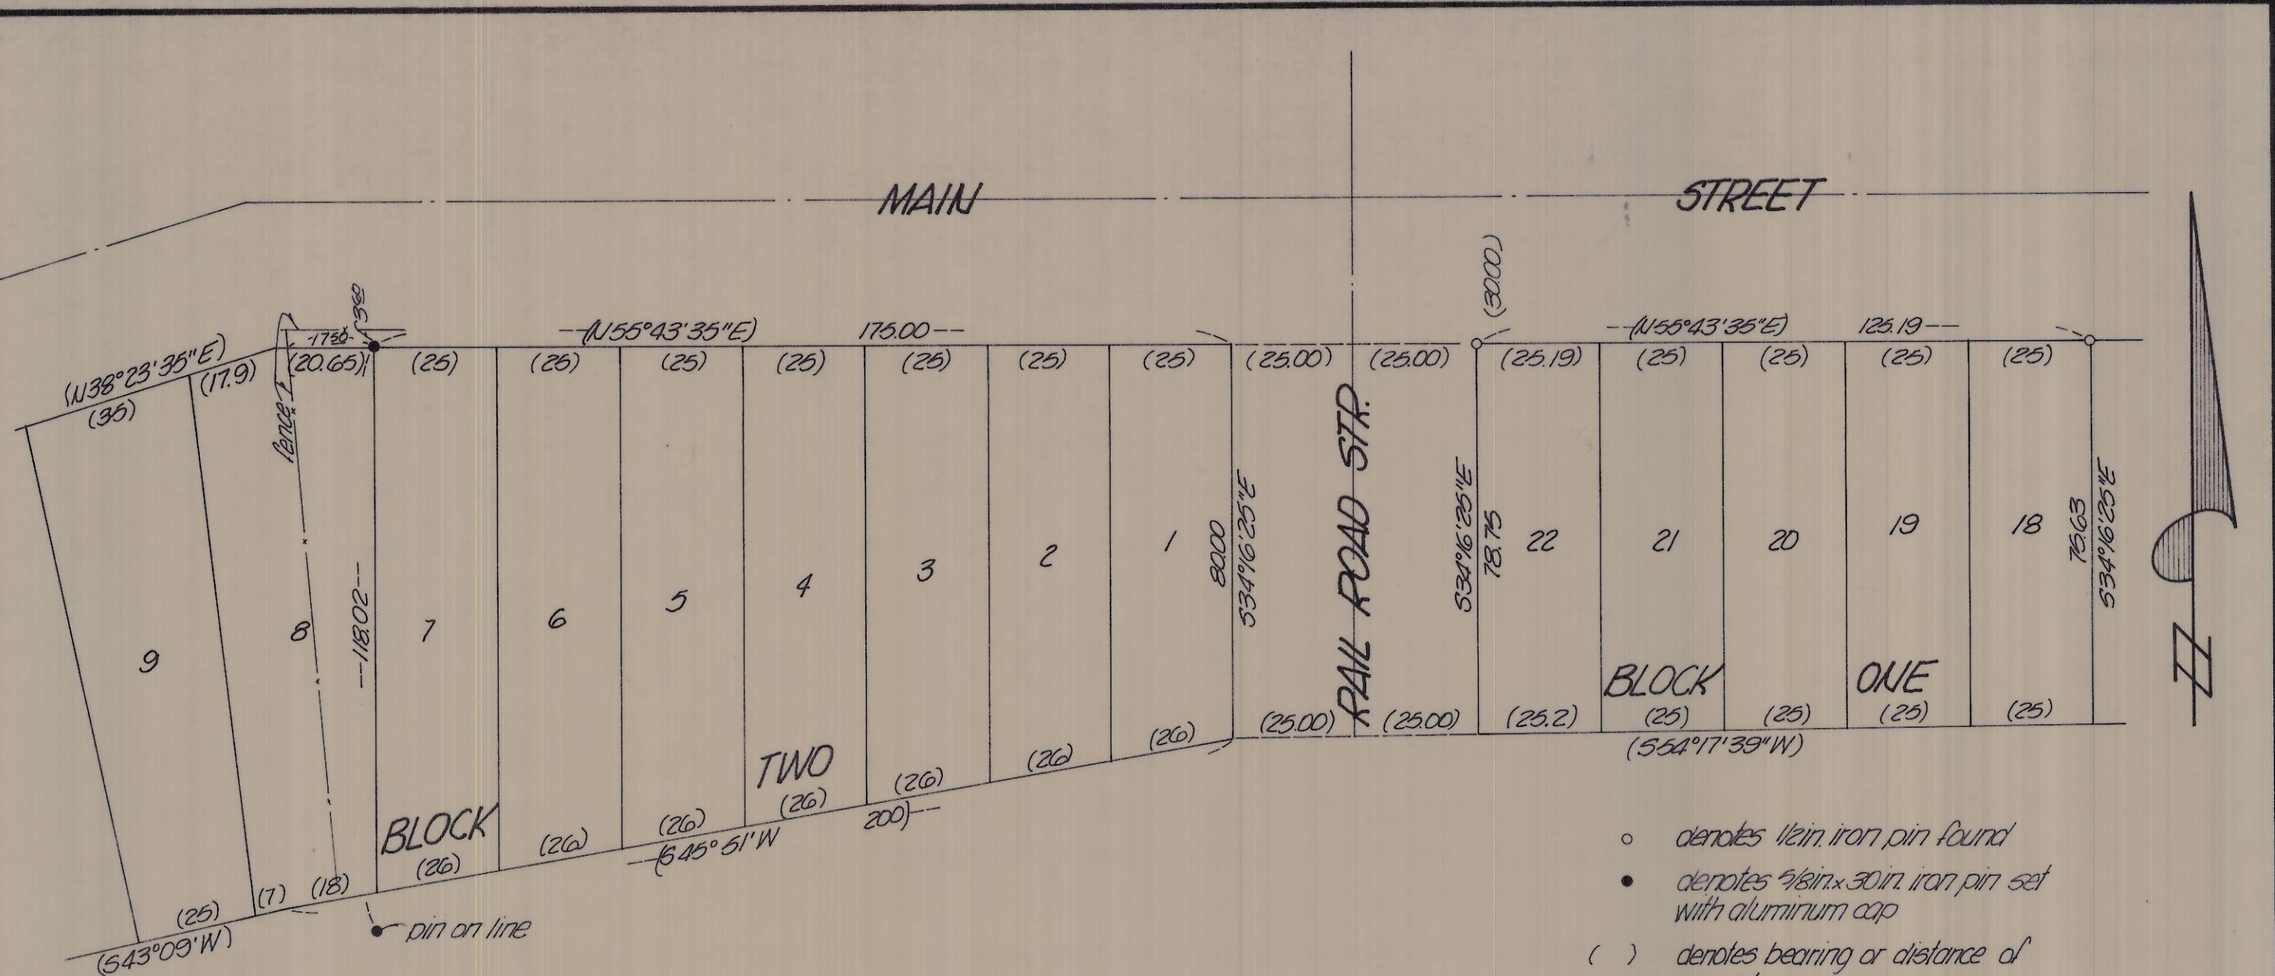

- ○ denotes 1/2in. iron pin found
- ● denotes 5/8in.x 30in. iron pin set with aluminum cap
- ( ) denotes bearing or distance of record

NARRATIVE

The purpose of this survey was to set pins set along the East line of Lot 8, Block 2, "Geonakopulos Addition" to (Doris) Keith, Umatilla County, Oregon. We used pins previously found or set by Krumbein Engineering, Co. in August 1966 in a survey for Cass, Spour and Meacham in Block 1 of said "Geonakopulos Addition.

Bearings and distances are based upon the original Plat of "Geonakopulos Addition."

RECEIVED BY
Umatilla County Surveyor
Date 22-June
Rec'd By BLS
No. 82-30-S

REGISTERED PROFESSIONAL LAND SURVEYOR
David H Klein
OREGON
JULY 10, 1970
DAVID H. KRUMBEIN
2147
David H Klein

KRUMBEIN ENGINEERING CO.
ENGINEERS – SURVEYORS – PLANNERS
221 S. Main, Pendleton, Oregon

Survey for
JOHN WERNLUND
Lot 8, Blk 2, "Geonakopulos Addition", (Doris) Keith, Oregon

SCALE	1" = 30'
DATE	March 2, 1982
DRN. BY	MH
CKD. BY	DHK
DRNG. NO.	82-078

82-30-A