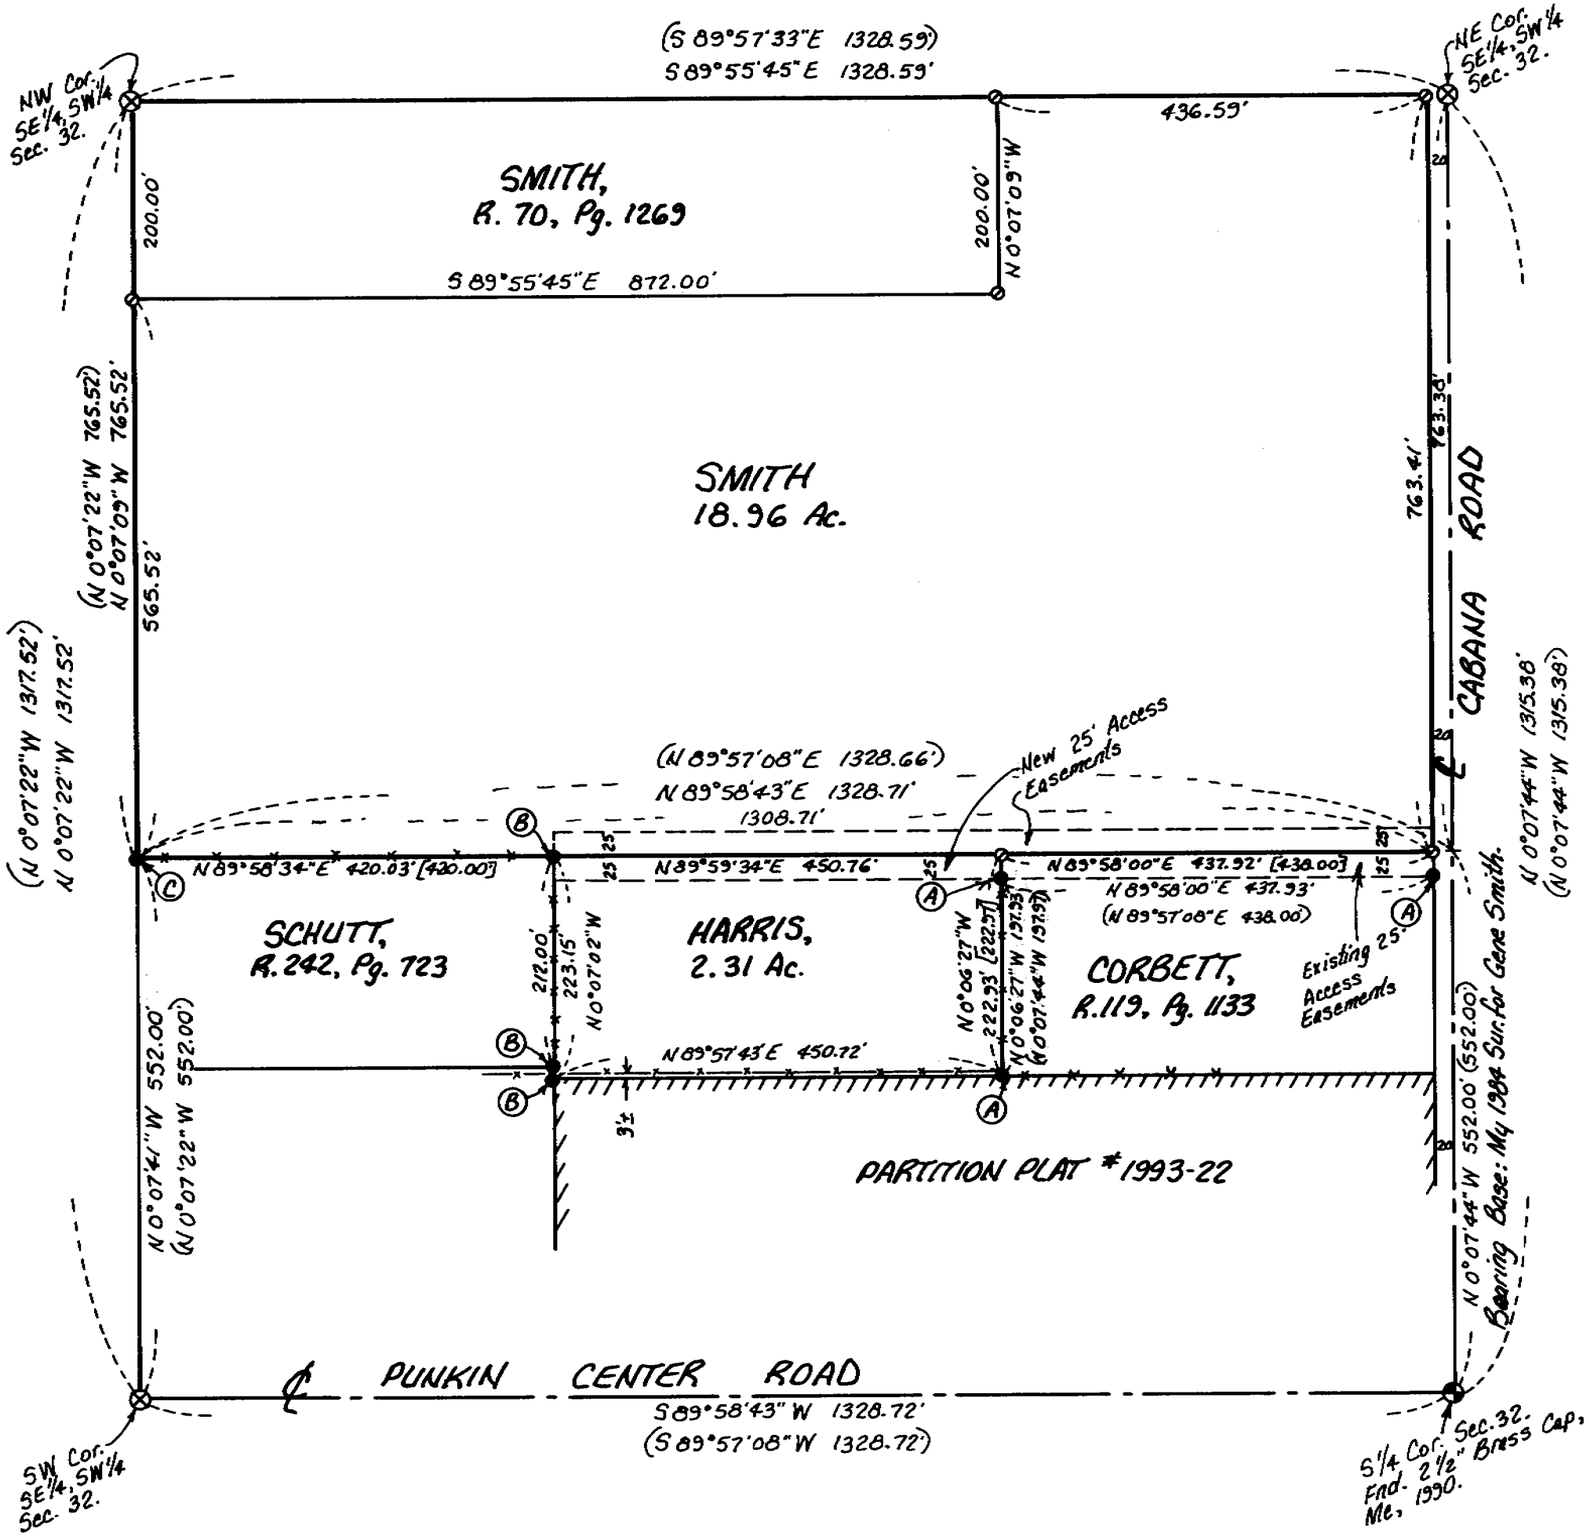

NARRATIVE:

The purpose of this survey is to show a boundary line adjustment between two parcels, an approximately 4 acre parcel deeded to H. Eugene Smith, et ux, in Reel 70, Page 1269 and a 21.27 acre parcel deeded to Carl and Madge Harris in Reel 212, Page 195.

The North 18.96 acres of Harris' parcel is to be added to Smith's approximately 4 acres.

All of the corners of the 2.31 acre parcel that Harris is going to retain are monumented as shown. I tied those corners and computed the location on what will be Smith's North line. I did not set Smith's North corners but his South corners are in as are all of Harris' corners.

Scale: 1" = 152'

0 76 152 304

REGISTERED PROFESSIONAL LAND SURVEYOR

G. Dennis Edwards

OREGON JULY 16, 1971 G. DENNIS EDWARDS 951

RENEWS 12/31/97

LEGEND:

- Monuments found:
  - (A) ½" rebar, Mc, 1984 survey for Gene Smith.
  - (B) 5/8" rebar, McKinnis, Partition Plat #1993-22.
  - (C) ½" rebar, Mc, 1991 survey for Hamm.
- ⊗ Computed location of 1/16 corners from my 1984 survey for Gene Smith.
- ⊙ Computed location of Deed corners.
- (ooo) of Record. My 1984 survey for Gene Smith.
- [ooo] of Record. Deeds, as noted.

RECEIVED BY
Umatilla County Surveyor
Date 12-97
Rec'd By KK
No. 97-232-A

Survey for GENE SMITH
In SW¼ Section 32, T5N, R29E, W.M.,
Umatilla County, Oregon
11/24/97 Job #S9709224
Edwards Surveying P.O. Box 763
541-567-3336 Hermiston, Oregon 97838

97-232-A