


**NARRATIVE:**

The purpose of this survey is to locate the corners of lots 16 and 17, Block 14, "NEWPORT ADDITION" to the City of Hermiston, for a pending sale. This parcel is described in a deed to Vernon Piel, recorded on Reel 25, Page 1745, Umatilla County Deed Records. I found the South corners of lot 17 (origin unknown) and confirmed their location with ties to my survey of lot 13 for Mosqueda in 1997 and my survey of lot 19, Block 13 for Lowrance in 1990.

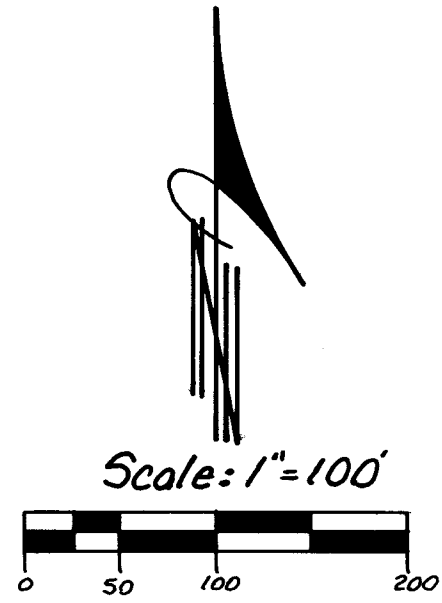

REGISTERED  
PROFESSIONAL  
LAND SURVEYOR

*G. Dennis Edwards*

OREGON  
JULY 16, 1971  
G. DENNIS EDWARDS  
951

RENEWS 12/31/99

RECEIVED BY

Umatilla County Surveyor

Date 5-98

Rec'd By JK

No. 98-86-A

**LEGEND:**

- Found monuments: 5/8" rebar with plastic cap #951, set by Me in 1997 survey for Mosqueda, unless noted otherwise.
  - Set 5/8" x 30" rebar with plastic cap #951.
- (ooo) of Record. 1908 Plat of "NEWPORT ADDITION"

Survey for **VERN PIEL**  
In Block 14, "NEWPORT ADDITION" to City of Hermiston,  
In the SW 1/4 of Section 11, T4N, R28E, W. M.,  
Umatilla County, Oregon  
2/10/98 Job #59801023  
Edwards Surveying P.O. Box 163  
541-567-3336 Hermiston, Oregon 97838

28-86-A