

SURVEYORS NARRATIVE:

THE PURPOSE OF THIS SURVEY IS TO STAKE A BOUNDARY LINE ADJUSTMENT WHICH HAS BEEN COMPLETED. THE EAST LINE OF PARCEL ONE OF PARTITION PLAT 1997-20 WAS MOVED 12 FEET TO THE EAST TO TAKE PART OF THE REMAINDER OF THAT PARCEL DEEDED TO THE BEREAN SOCIETY INTERNATIONAL ON REEL 142, PAGE 95, UMATILLA COUNTY DEED RECORDS.

I SURVEYED BOTH PARCELS IN PARTITION PLAT 1997-20 AND THE BEARINGS AND THIS SURVEY ARE BASED ON SAID PARTITION PLAT.

LEGEND:

- FND. 5/8" IRON REBAR SET BY ME IN PARTITION PLAT 1997-20
- SET 5/8" X 30" IRON REBAR WITH PLASTIC CAP #951

LINE TABLE

L-1	N 89°49'20"E	12.00'
L-2	N 75°11'21"E	12.41'

REGISTERED
PROFESSIONAL
LAND SURVEYOR

G. Dennis Edwards

OREGON
JULY 16, 1971
G. DENNIS EDWARDS
851

RENEWS 12/31/99


RECEIVED BY

Umatilla County Surveyor

Date 6-99

Rec'd By JK

No. 99-110-A

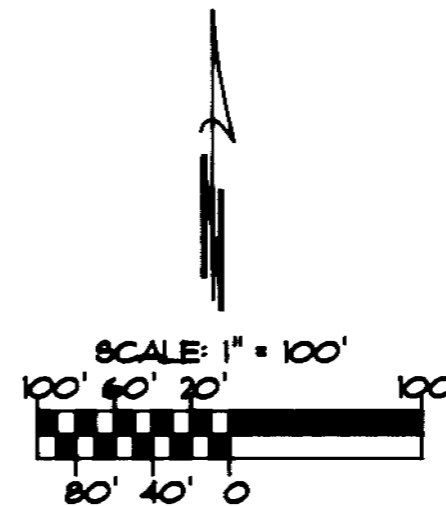

SURVEY FOR JOHN SHAFER
N NW 1/4, SEC. 20, T5N, R28E, W.M.,
UMATILLA COUNTY, OREGON
2/26/99 JOB NO. 9961247
EDWARDS SURVEYING P.O. BOX 763
541-567-3336 HERMISTON, OREGON 97838
DRAWN BY: LLC

99-110-A