

**LEGEND:**


- 5/8" IRON REBAR FOUND. SET BY ME IN PARTITION PLATS 1995-15, 1995-37, & 1996-40
- 5/8" X 30" IRON REBAR SET WITH PLASTIC CAP #951
- ⊙ COMPUTED LOCATION OF PARCEL CORNER
- SET PK NAIL OVER PARCEL CORNER

REGISTERED  
PROFESSIONAL  
LAND SURVEYOR

*G. Dennis Edwards*

OREGON  
JULY 18, 1971  
G. DENNIS EDWARDS  
951

RENEWS 12/31/99

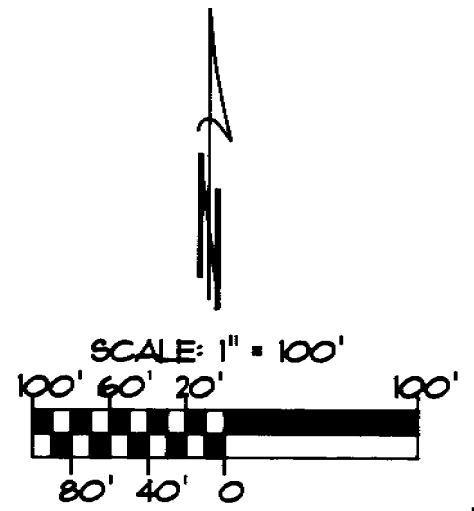

**SURVEYORS NARRATIVE:**

THE PURPOSE OF THIS SURVEY IS TO DO A LOT LINE ADJUSTMENT TO MOVE A PORTION OF THE SOUTH LINE OF PARCEL 3, PARTITION PLAT 1995-37, TO THE SOUTH AND EAST TO INCLUDE A PORTION OF PARCEL 1, PARTITION PLAT 1996-40, WHICH CONTAINS PART OF AN R.V. PARK. THE MAJORITY OF SAID R.V. PARK LIES IN PARCEL 3 OF PARTITION PLAT 1995-37. THE RESULT BEING THAT ALL OF THE R.V. PARK WILL BE IN ONE TAX LOT.

I BASED THE BEARING OF THIS SURVEY ON THE ABOVE MENTIONED PARTITION PLATS.

RECEIVED BY  
Umatilla County Surveyor  
Date 11-99  
Rec'd By KK  
No 99-267-A

SURVEY FOR TOM N. ABLE  
IN THE SW 1/4, OF THE SW 1/4,  
OF SECTION 13, T4N, R28E, W.M.,  
UMATILLA COUNTY, OREGON  
1/25/99 JOB NO. 99301021  
EDWARDS SURVEYING P.O. BOX 763  
541-567-3336 HERMISTON, OREGON 97838  
DRAWN BY: LLC

99-267-A