

REV. AREA
26,784 SQ. FT.

REV. AREA
14,545 SQ. FT.

CURVE DATA

#	RADIUS	LENGTH	CHORD
C1	75.00'	58.48'	S 67°13'12" E 57.01'
C2	10.00'	15.71'	S 0°07'08" W 14.14'
C3	75.00'	28.81'	S 56°07'25" W 28.63'

NARRATIVE:

THE PURPOSE OF THIS SURVEY IS TO ADJUST THE LINE BETWEEN LOTS 9 & 12, "RIVER HILL PHASE 2".
BILL WELLS SURVEYED THIS SUBDIVISION IN 1998 AND I USED HIS MONUMENTS WHICH HE SET TO STAKE THE NEW BOUNDARY LINE.


REGISTERED
PROFESSIONAL
LAND SURVEYOR

G. Dennis Edwards

OREGON
JULY 16, 1971
G. DENNIS EDWARDS
9 5 1
RENEWS 12/31/2001

LEGEND:

- FOUND 5/8" IRON REBAR, WELLS 1998 PLAT OF "RIVER HILL PHASE 2"
- SET 5/8"x30" IRON REBAR WITH PLASTIC CAP #951

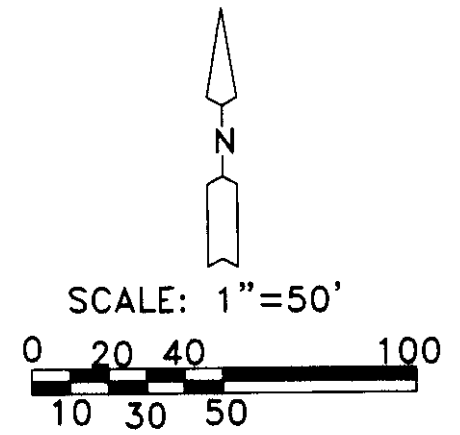

RECEIVED BY

Umatilla County Surveyor
Date 8-01
Rec'd By KK
No. 01-121-A

SURVEY FOR BUTCH DIXON
IN LOTS 9 & 12, "RIVER HILL, PHASE 2",
IN NE 1/4, SEC. 16, T 4 N, R 28 E,
W.M., UMATILLA COUNTY, OREGON
4/10/2001 JOB# S0104063
EDWARDS SURVEYING P.O. BOX 763
541-567-3336 HERMISTON, OREGON 97838
DRAWN BY NJF

01-121-A