

NARRATIVE:

THE PURPOSE OF THIS SURVEY IS TO SET THE EAST 2 CORNERS OF LOT 12, BLOCK "E", "HERMISTON ORCHARDS" FOR POSSIBLE FUTURE DEVELOPMENT.

I SET THE WEST 2 CORNERS IN A MARCH 2002 SURVEY FOR COHUT. THE BEARINGS AND THIS SURVEY ARE BASED ON SAID COHUT SURVEY.

REGISTERED
PROFESSIONAL
LAND SURVEYOR

G. Dennis Edwards

OREGON
JULY 16, 1971
G. DENNIS EDWARDS
9 5 1
RENEWS 12/31/2003

LEGEND:

- MONUMENTS FOUND AS NOTED
- ⊙ FND. 5/8" IRON REBAR, ME 2/02 SURVEY FOR COHUT
- SET 5/8"X30" IRON REBAR WITH PLASTIC CAP #951
- (000) OF RECORD, PLAT OF "HERMISTON ORCHARDS"

RECEIVED BY


Umatilla County Surveyor

Date 6-02

Rec'd By KK

No. 02-157-A

SURVEY FOR JACK RASMUSSEN
IN LOT 12, BLK. "E", "HERMISTON ORCHARDS",
IN NW 1/4, SE 1/4, SEC. 11, T 4 N, R 28 E, W.M.,
CITY OF HERMISTON, UMATILLA COUNTY, OREGON
5/8/2002 JOB# S0203069-A
EDWARDS SURVEYING P.O. BOX 763
541-567-3336 HERMISTON, OREGON 97838
DRAWN BY NJF

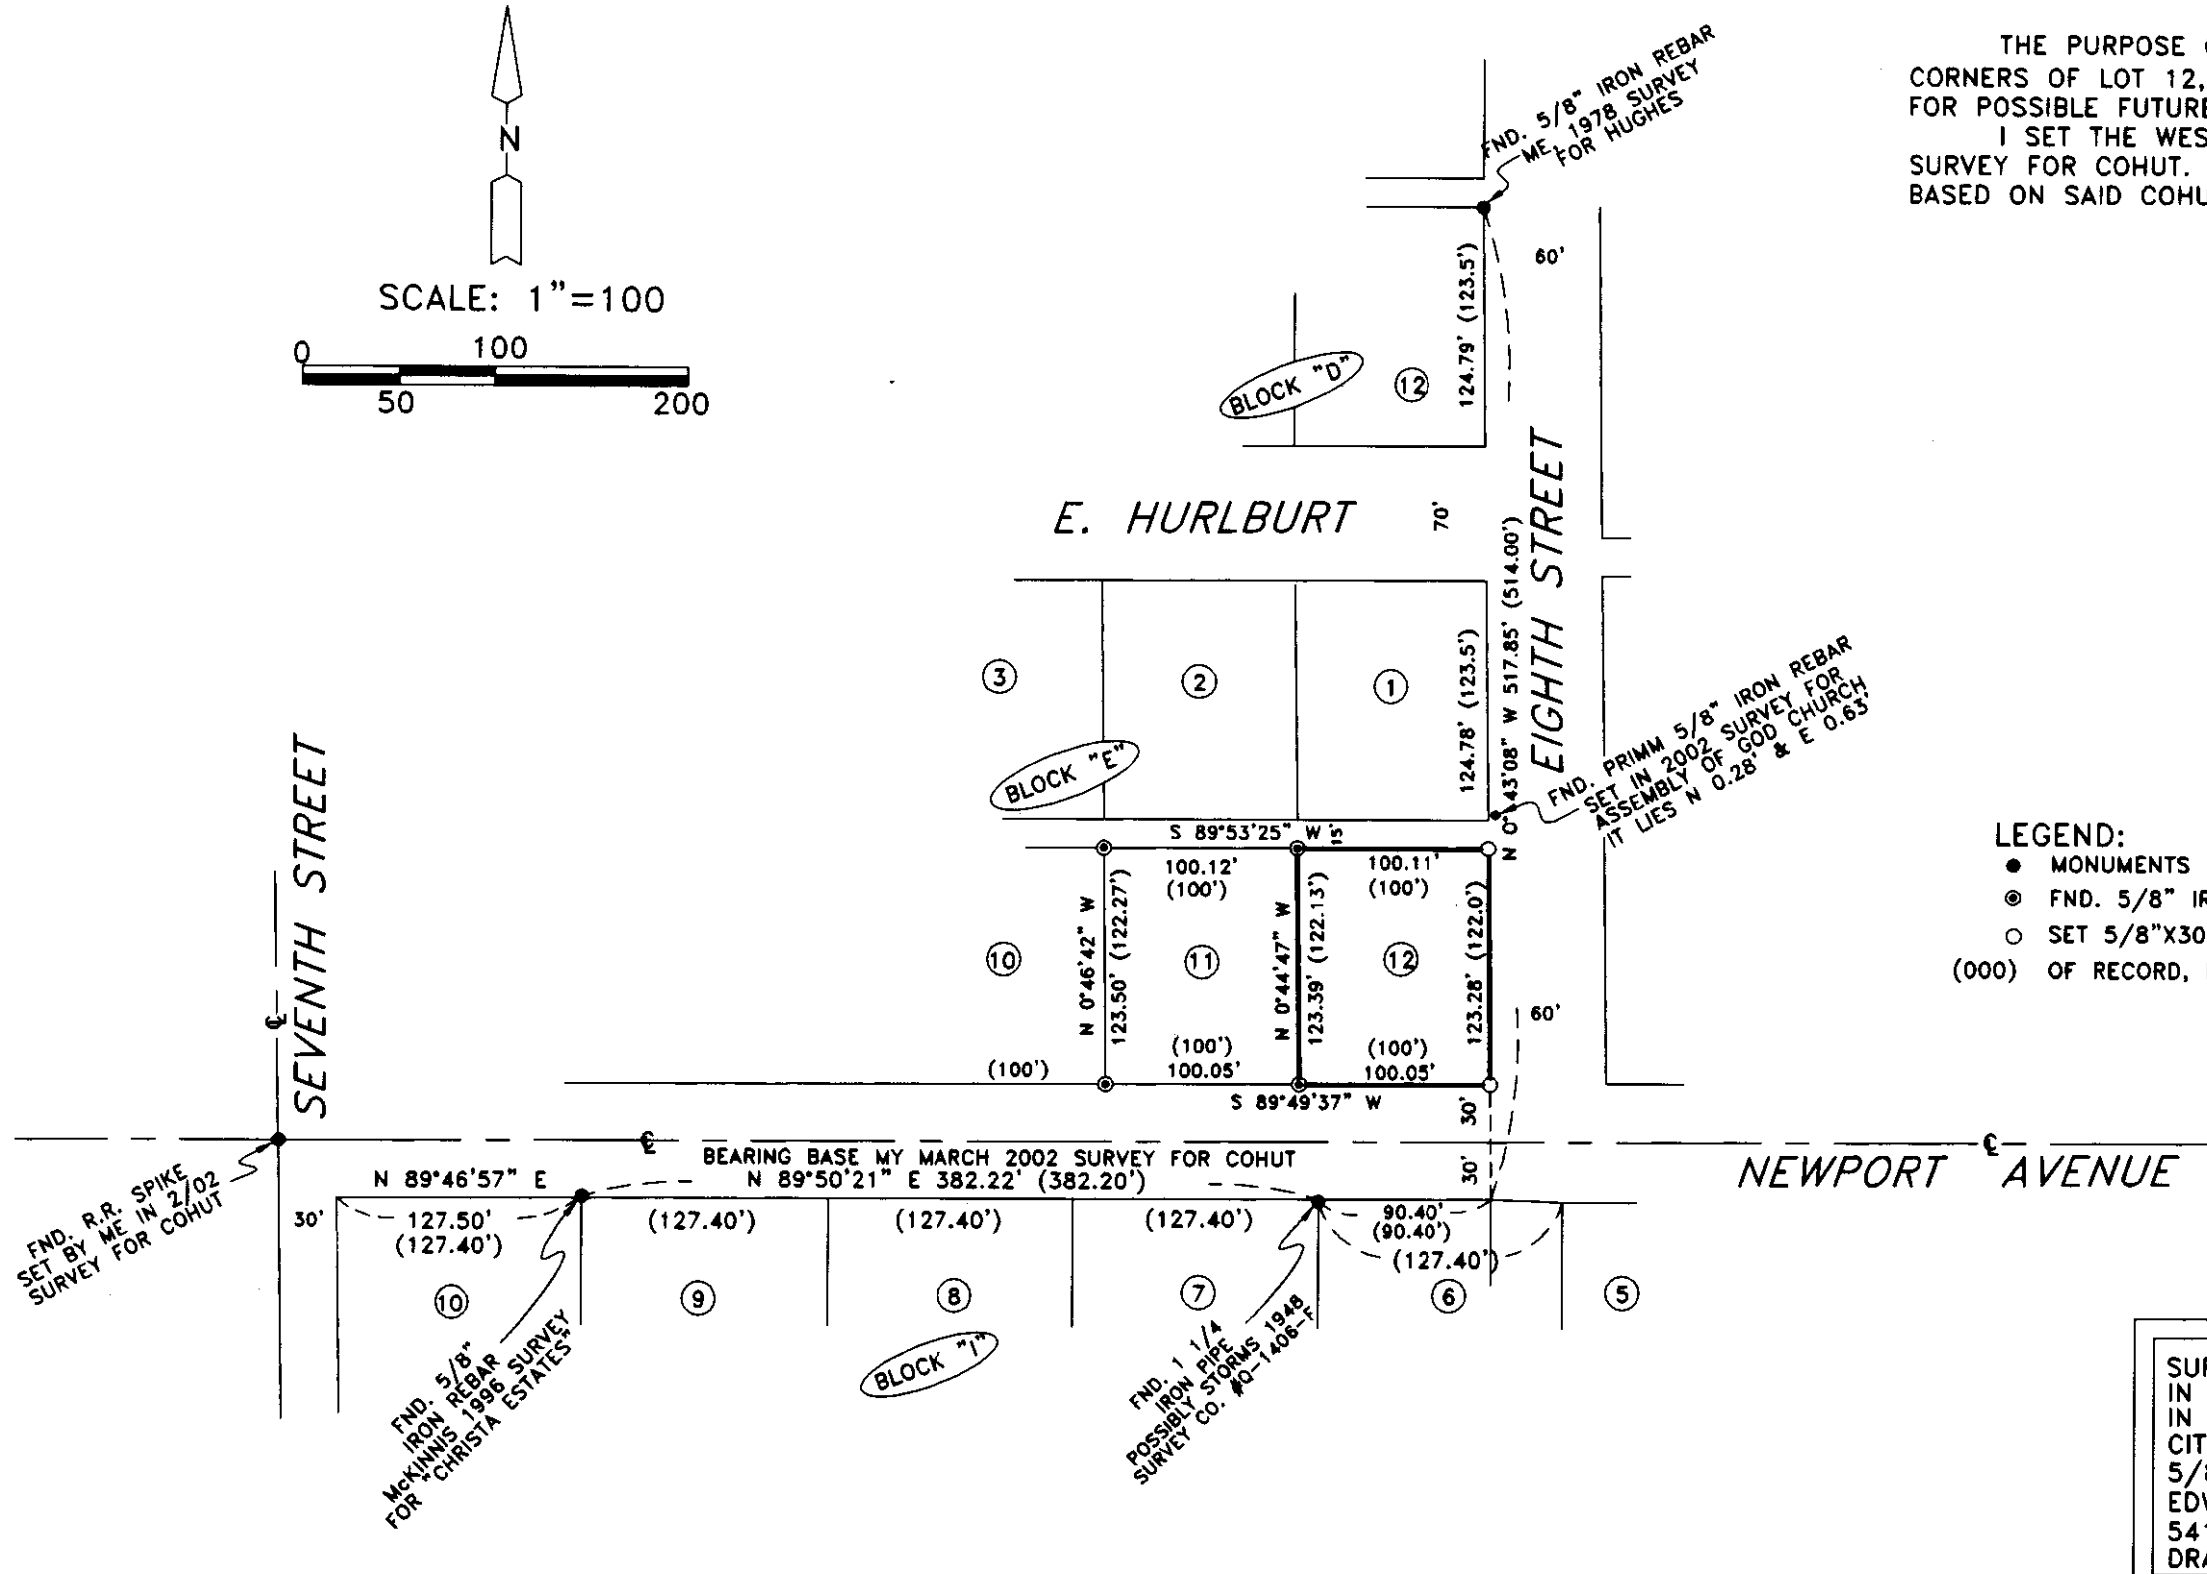

02-157-B