


NARRATIVE:

THE PURPOSE OF THIS SURVEY IS TO DO A BOUNDARY LINE ADJUSTMENT TO ADD THE EAST 75.00 FEET OF THAT TRACT OF LAND DEEDED TO RAY F. ARRIOLA ON REEL 335, PAGE 725, TO PARCEL ONE OF PARTITION PLAT 2002-18.
 I BASED THIS SURVEY AND THE BEARINGS ON MY PARTITION PLAT 2002-18.
 THE DESCRIPTION OF THE PARCEL WHICH IS GOING TO BE TRANSFERRED FROM ARRIOLA TO LINDER IS THE NORTH 75.00 FEET OF THE EAST 75.00 FEET OF LOT 20, BLOCK 14, "NEWPORT ADDITION" TO THE CITY OF HERMISTON, UMATILLA COUNTY, OREGON.

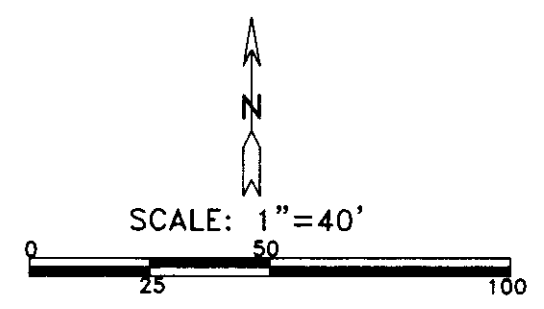

REGISTERED
 PROFESSIONAL
 LAND SURVEYOR
G. Dennis Edwards
 OREGON
 JULY 16, 1971
 G. DENNIS EDWARDS
 9 5 1
 RENEWS 12/31/2003

LEGEND:

- MONUMENTS FOUND AS NOTED
- SET 5/8"X30" IRON REBAR WITH PLASTIC CAP #951
- ⊙ FOUND 5/8" IRON REBAR, ME, PARTITION PLAT 2002-18
- (000) OF RECORD, 1908 PLAT OF "NEWPORT ADDITION"

SURVEY FOR ROBERT LINDER
 IN LOT 20, BLOCK 14, "NEWPORT ADDITION",
 TO THE CITY OF HERMISTON, IN SW 1/4, SECTION 11,
 T 4 N, R 28 E, W.M., UMATILLA COUNTY, OREGON
 6/5/02 JOB# S0202041A
 EDWARDS SURVEYING P.O. BOX 763
 541-567-3336 HERMISTON, OREGON 97838
 DRAWN BY NJF

RECEIVED BY
Umatilla County Surveyors
 Date 6-02
 Rec'd By KE
 No. 02-158-A

02-158-B