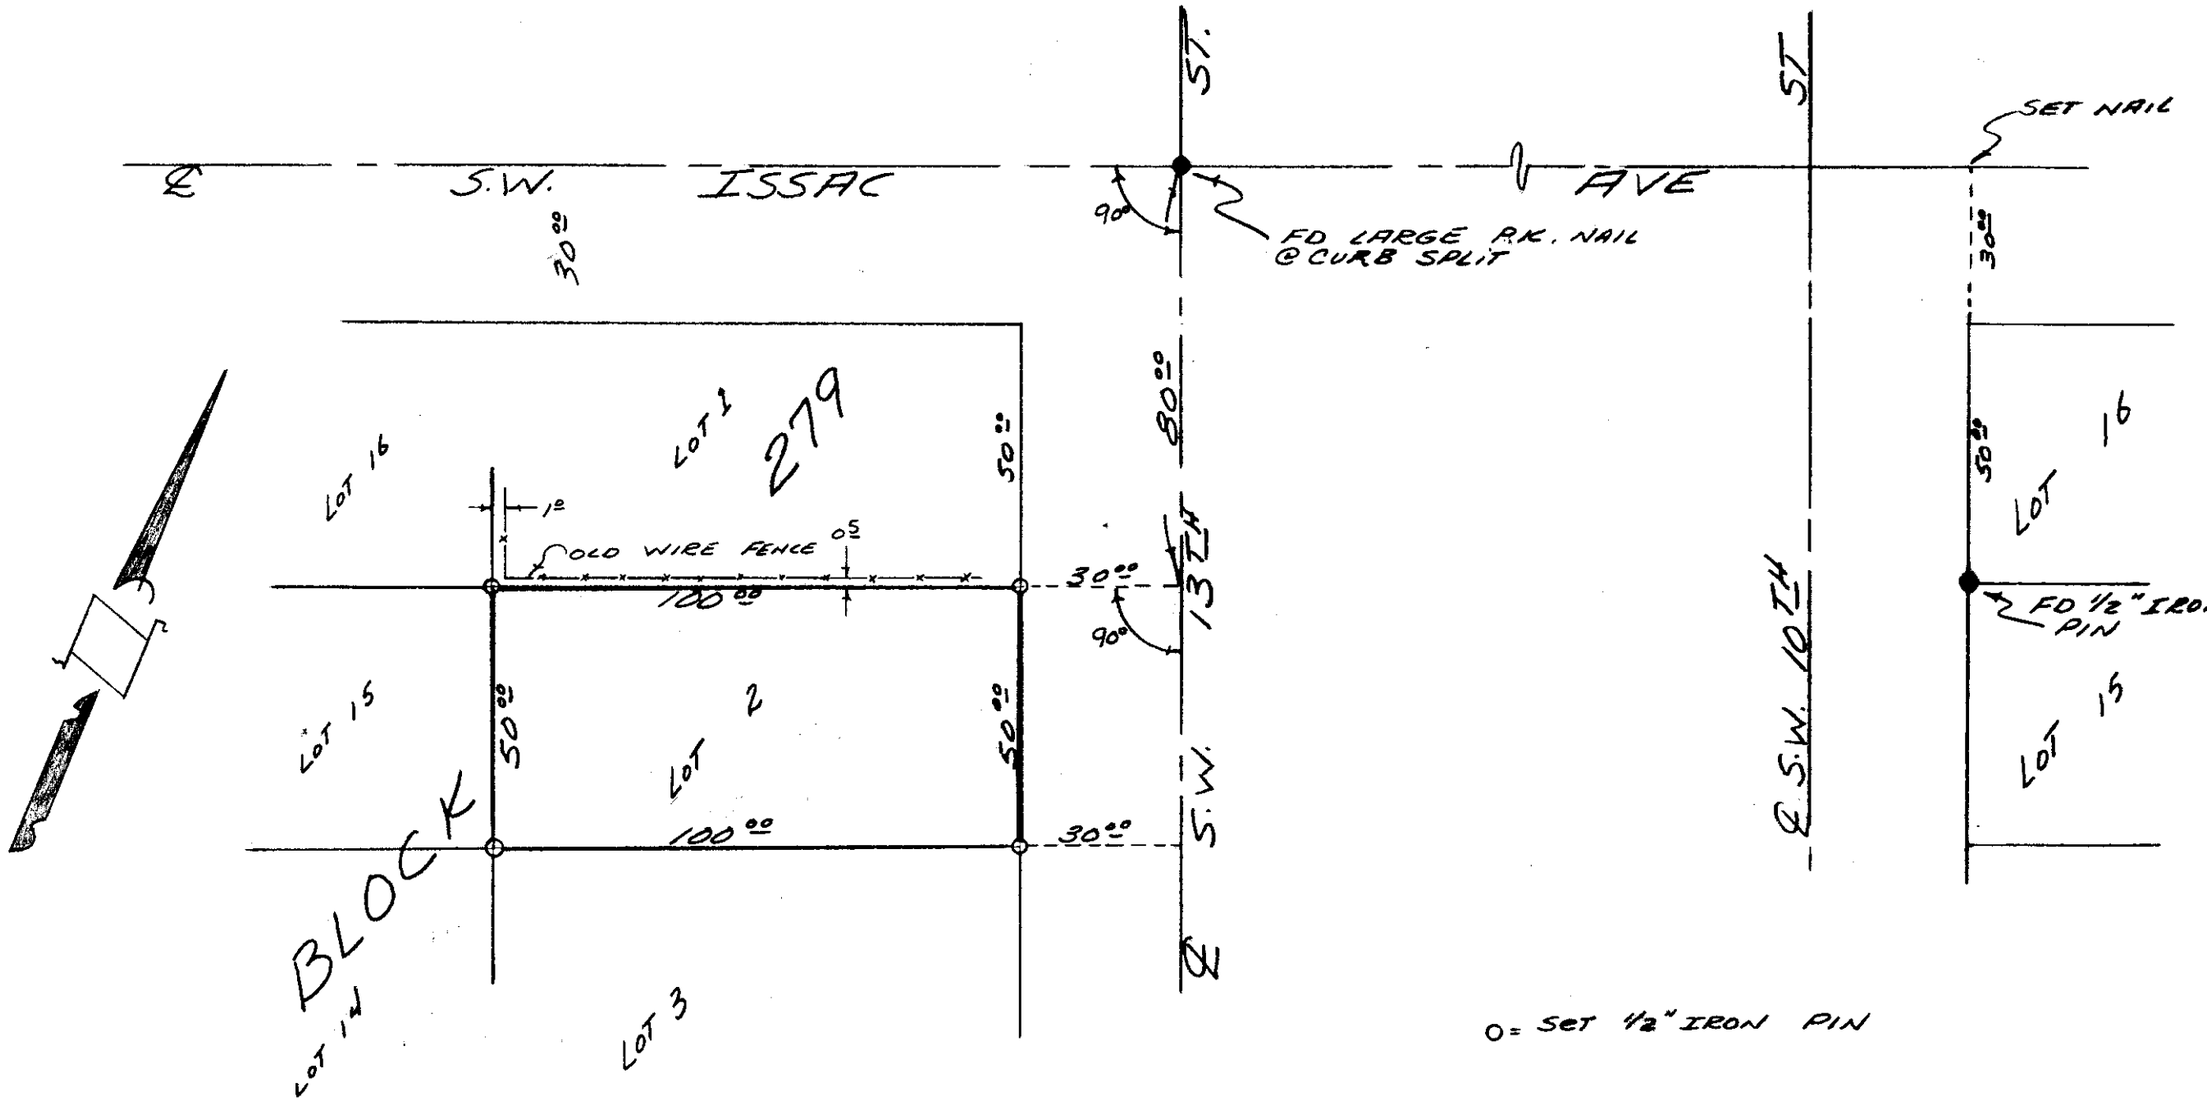

REGISTERED
OREGON
LAND SURVEYOR
Wayne O. Harris
MAY 6, 1958
WAYNE O. HARRIS
346

2N32 10 DC

CHAD WINDOM LOT 2 BLOCK 279 RESERVATION ADDITION	WAYNE HARRIS CO. INC. ENGINEERS-SURVEYORS PENDLETON, ORE				
	SCALE	DATE	DWN	CHK	DWG. NO
	1" = 30'	7-23-79	G.K.S.	W.O.H.	79-433A

02-289-A