


UMATILLA RIVER

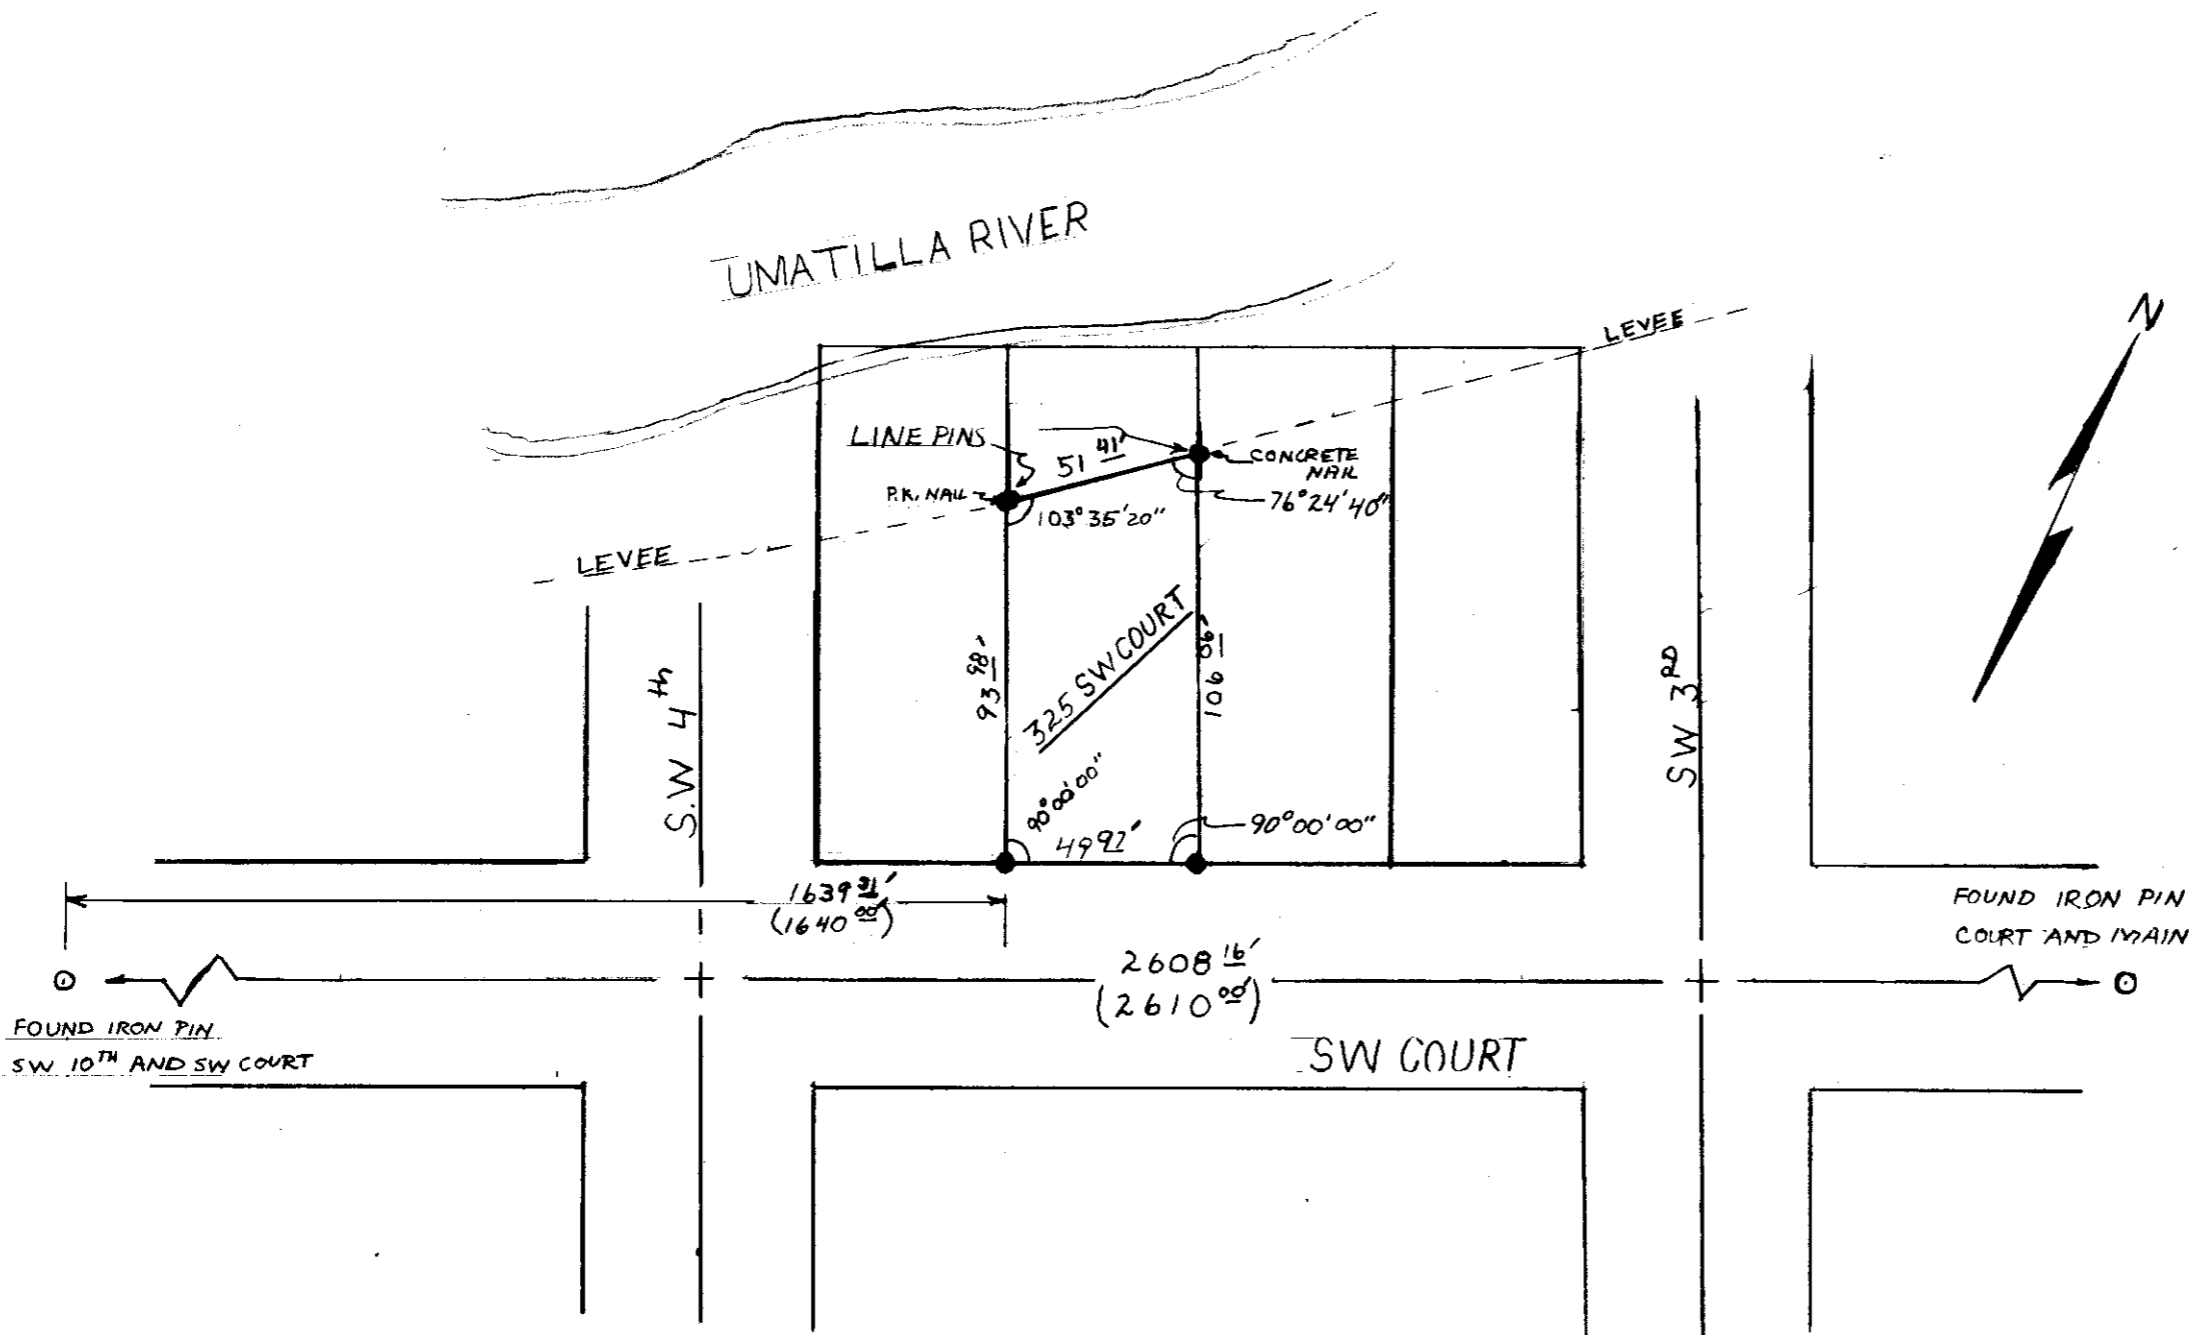

- LEGEND**
- POINTS FOUND
  - POINTS SET
  - ( ) DENOTES RECORD DISTANCE



REGISTERED  
OREGON  
LAND SURVEYOR

*Wayne O. Harris*  
MAY 6, 1955  
WAYNE O. HARRIS  
346

SURVEY OF LOT 3, BLOCK 33, ARNOLD  
AND RALEY'S ADDITION FOR MRS. GLADYS  
MIMS.  
LOCATED IN SW 1/4, NE 1/4, S 10, T 2N, R 32E, W 1/4

WAYNE HARRIS CO. INC.				
ENGINEERS - SURVEYORS		PENDLETON, ORE		
SCALE	DATE	DWN	CHK	DWG. NO
1"=50'	8-7-78	MGM	IGD	78-406A

02-247-A

02-247-A