


BLOCK 10
SWITZLER ADD'N.

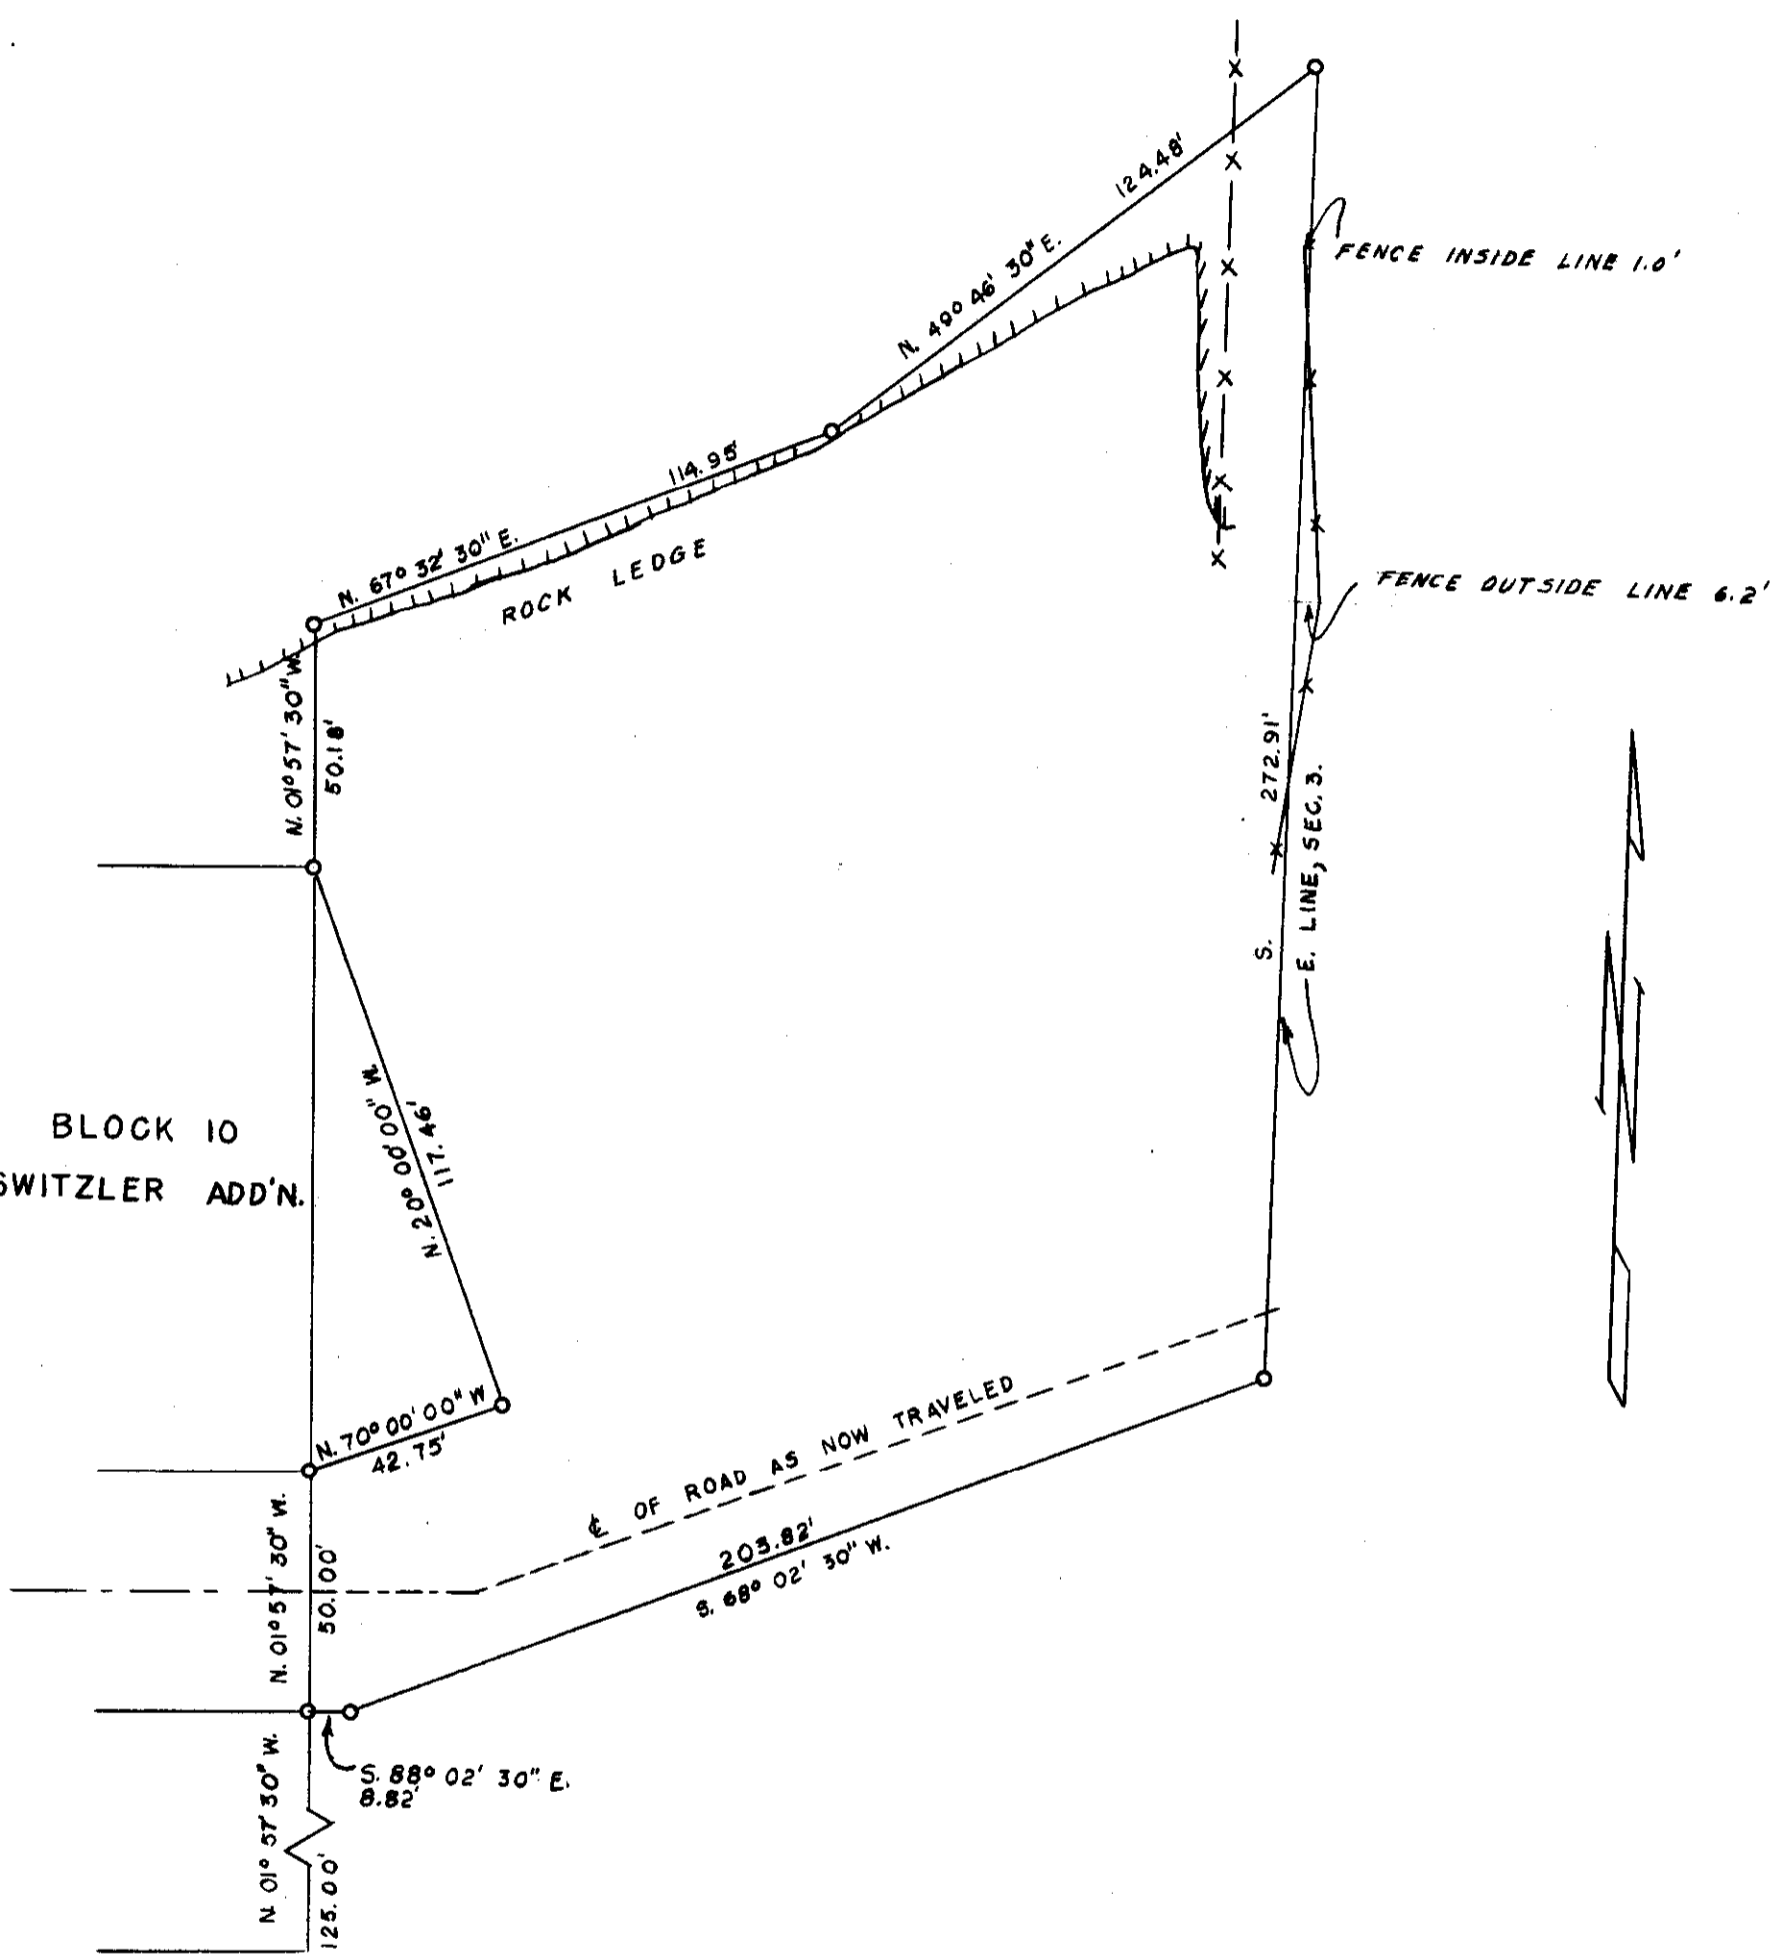

03-150-A

REGISTERED
OREGON
LAND SURVEYOR
Wayne O. Harris
MAY 6, 1955
WAYNE O. HARRIS
346

03-150-A

HAYES AND HARRIS			
Survey For LEONARD LORENZEN			
A Tract In The S.E. 1/4 Section 3 T. 2 N., R. 32 E., W.M.			
Scale	Date	Drn. By	Drng. No.
1"=40'	1/19/59	WOH	59-74A