


COLLEGE ST.



GARFIELD ST.

HIESTAND ST.

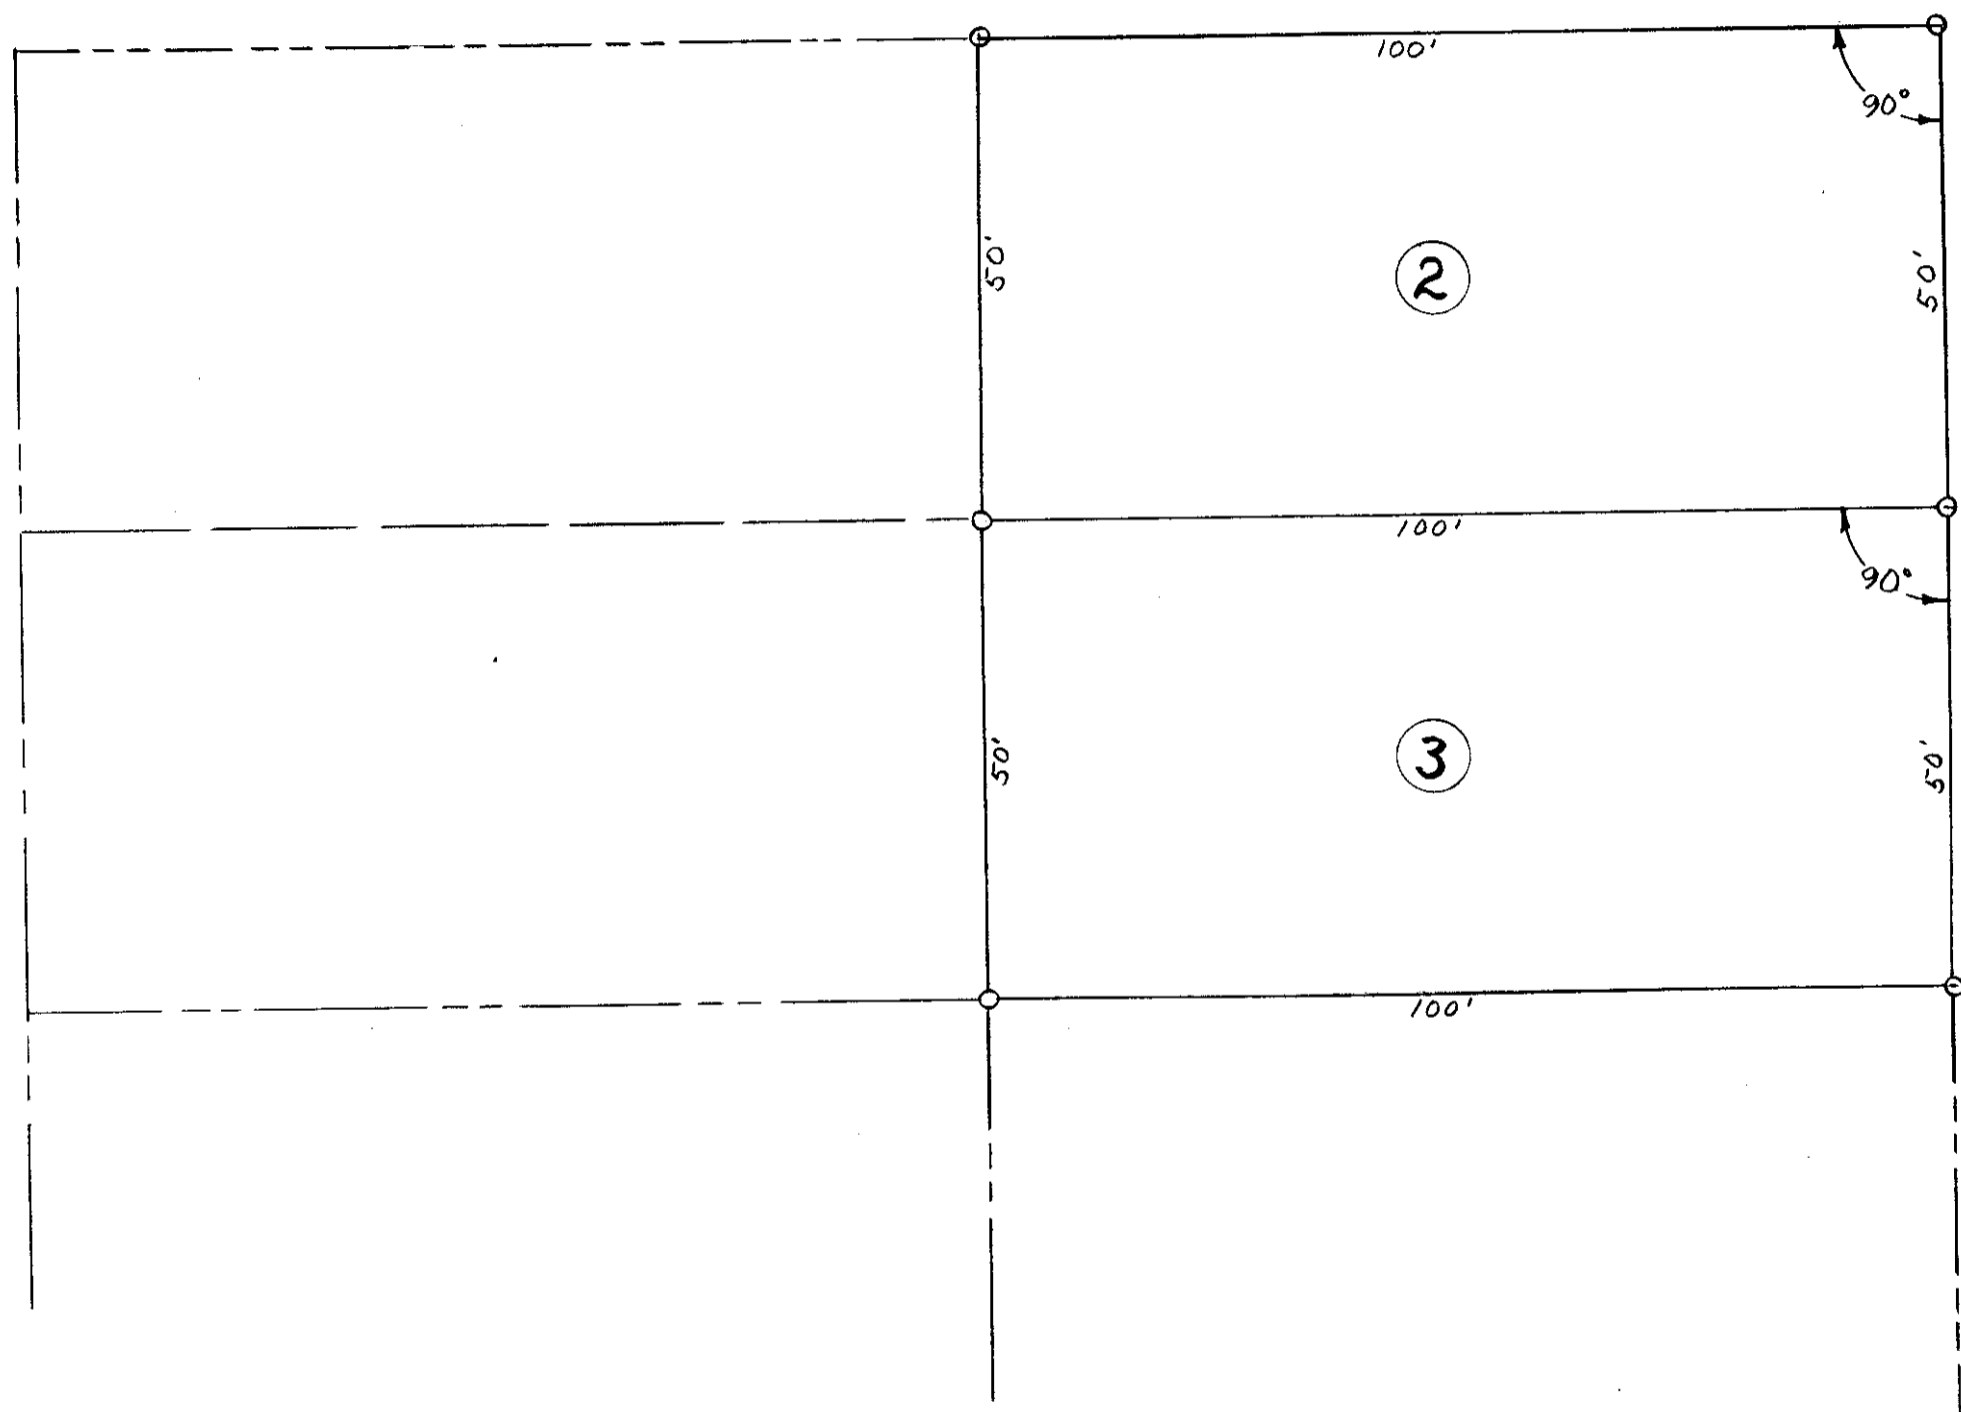

○ INDICATES 1/2" IRON PIN SET



30 29 16 DA

03-168-A

SURVEY LOTS 2 & 3 BLK 1		WAYNE HARRIS CO. INC.		
W.W. WHITWORTH'S ADD		ENGINEERS-SURVEYORS PENDLETON, OREGON		
ECHO		SCALE	DATE	DRN BY
FOR JAMES R SCHROEDER		1" = 20'	2-10-76	EQH
		CKD BY	CTP	DRNG NO.
				76-370A

76-105