


REGISTERED
 OREGON
 LAND SURVEYOR

David H. Kumbien
 JULY 17, 1970
 DAVID H. KUMBIEIN
 923

03-208-A

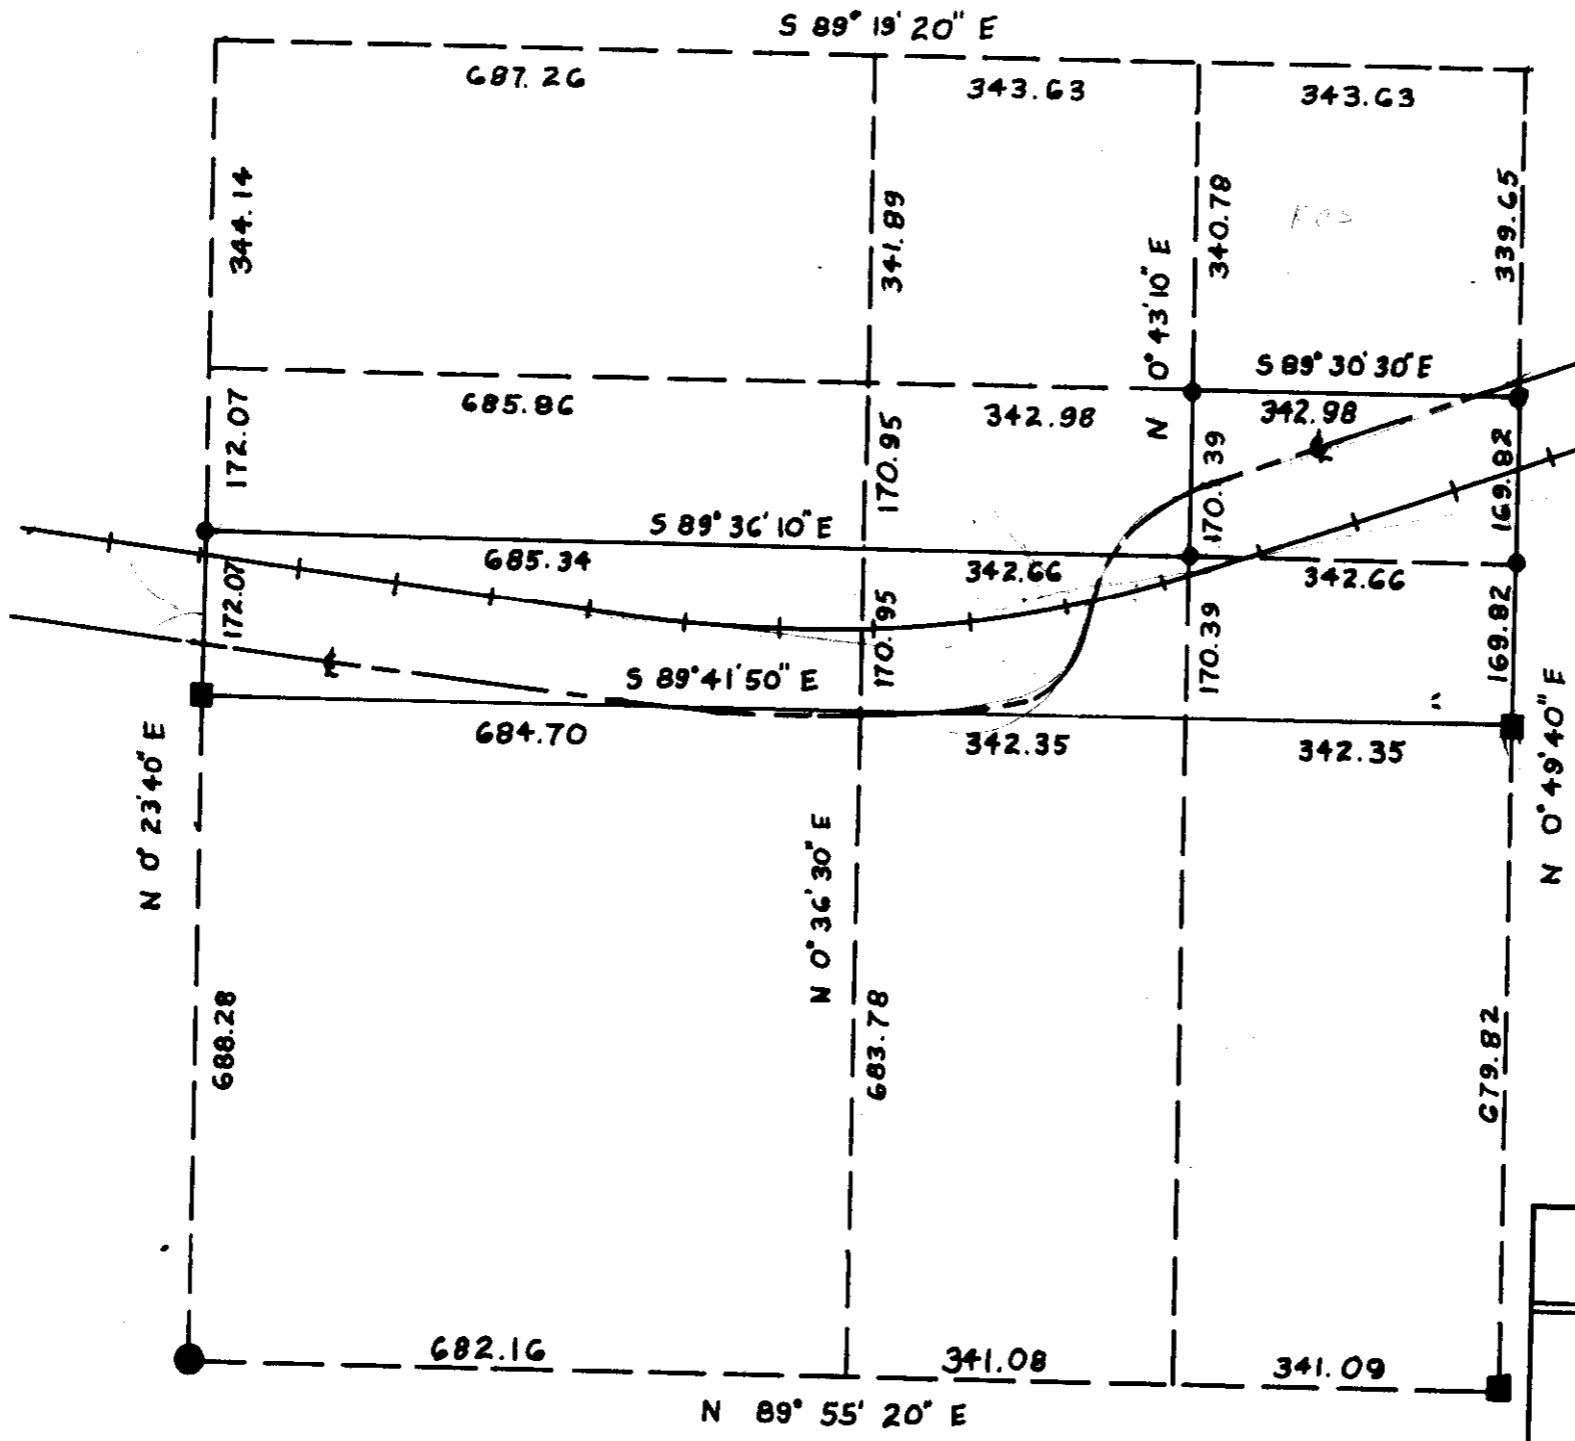

- INDICATES 5/8" I. PIN SET
- INDICATES BRASS CAP SET
- INDICATES BRASS CAP FND.

WAYNE HARRIS CO. INC.

SUPPLEMENT DRAWING TO
 71-271-C
 SHOWING THE
 SW 1/4, NE 1/4, SECTION 6, T.2N., R.35E.

SCALE	DATE	DRWN. BY	DRNG. No.
1"=200'	8-18-71	DHK	71-232-A

03-208-A