


03-220-A

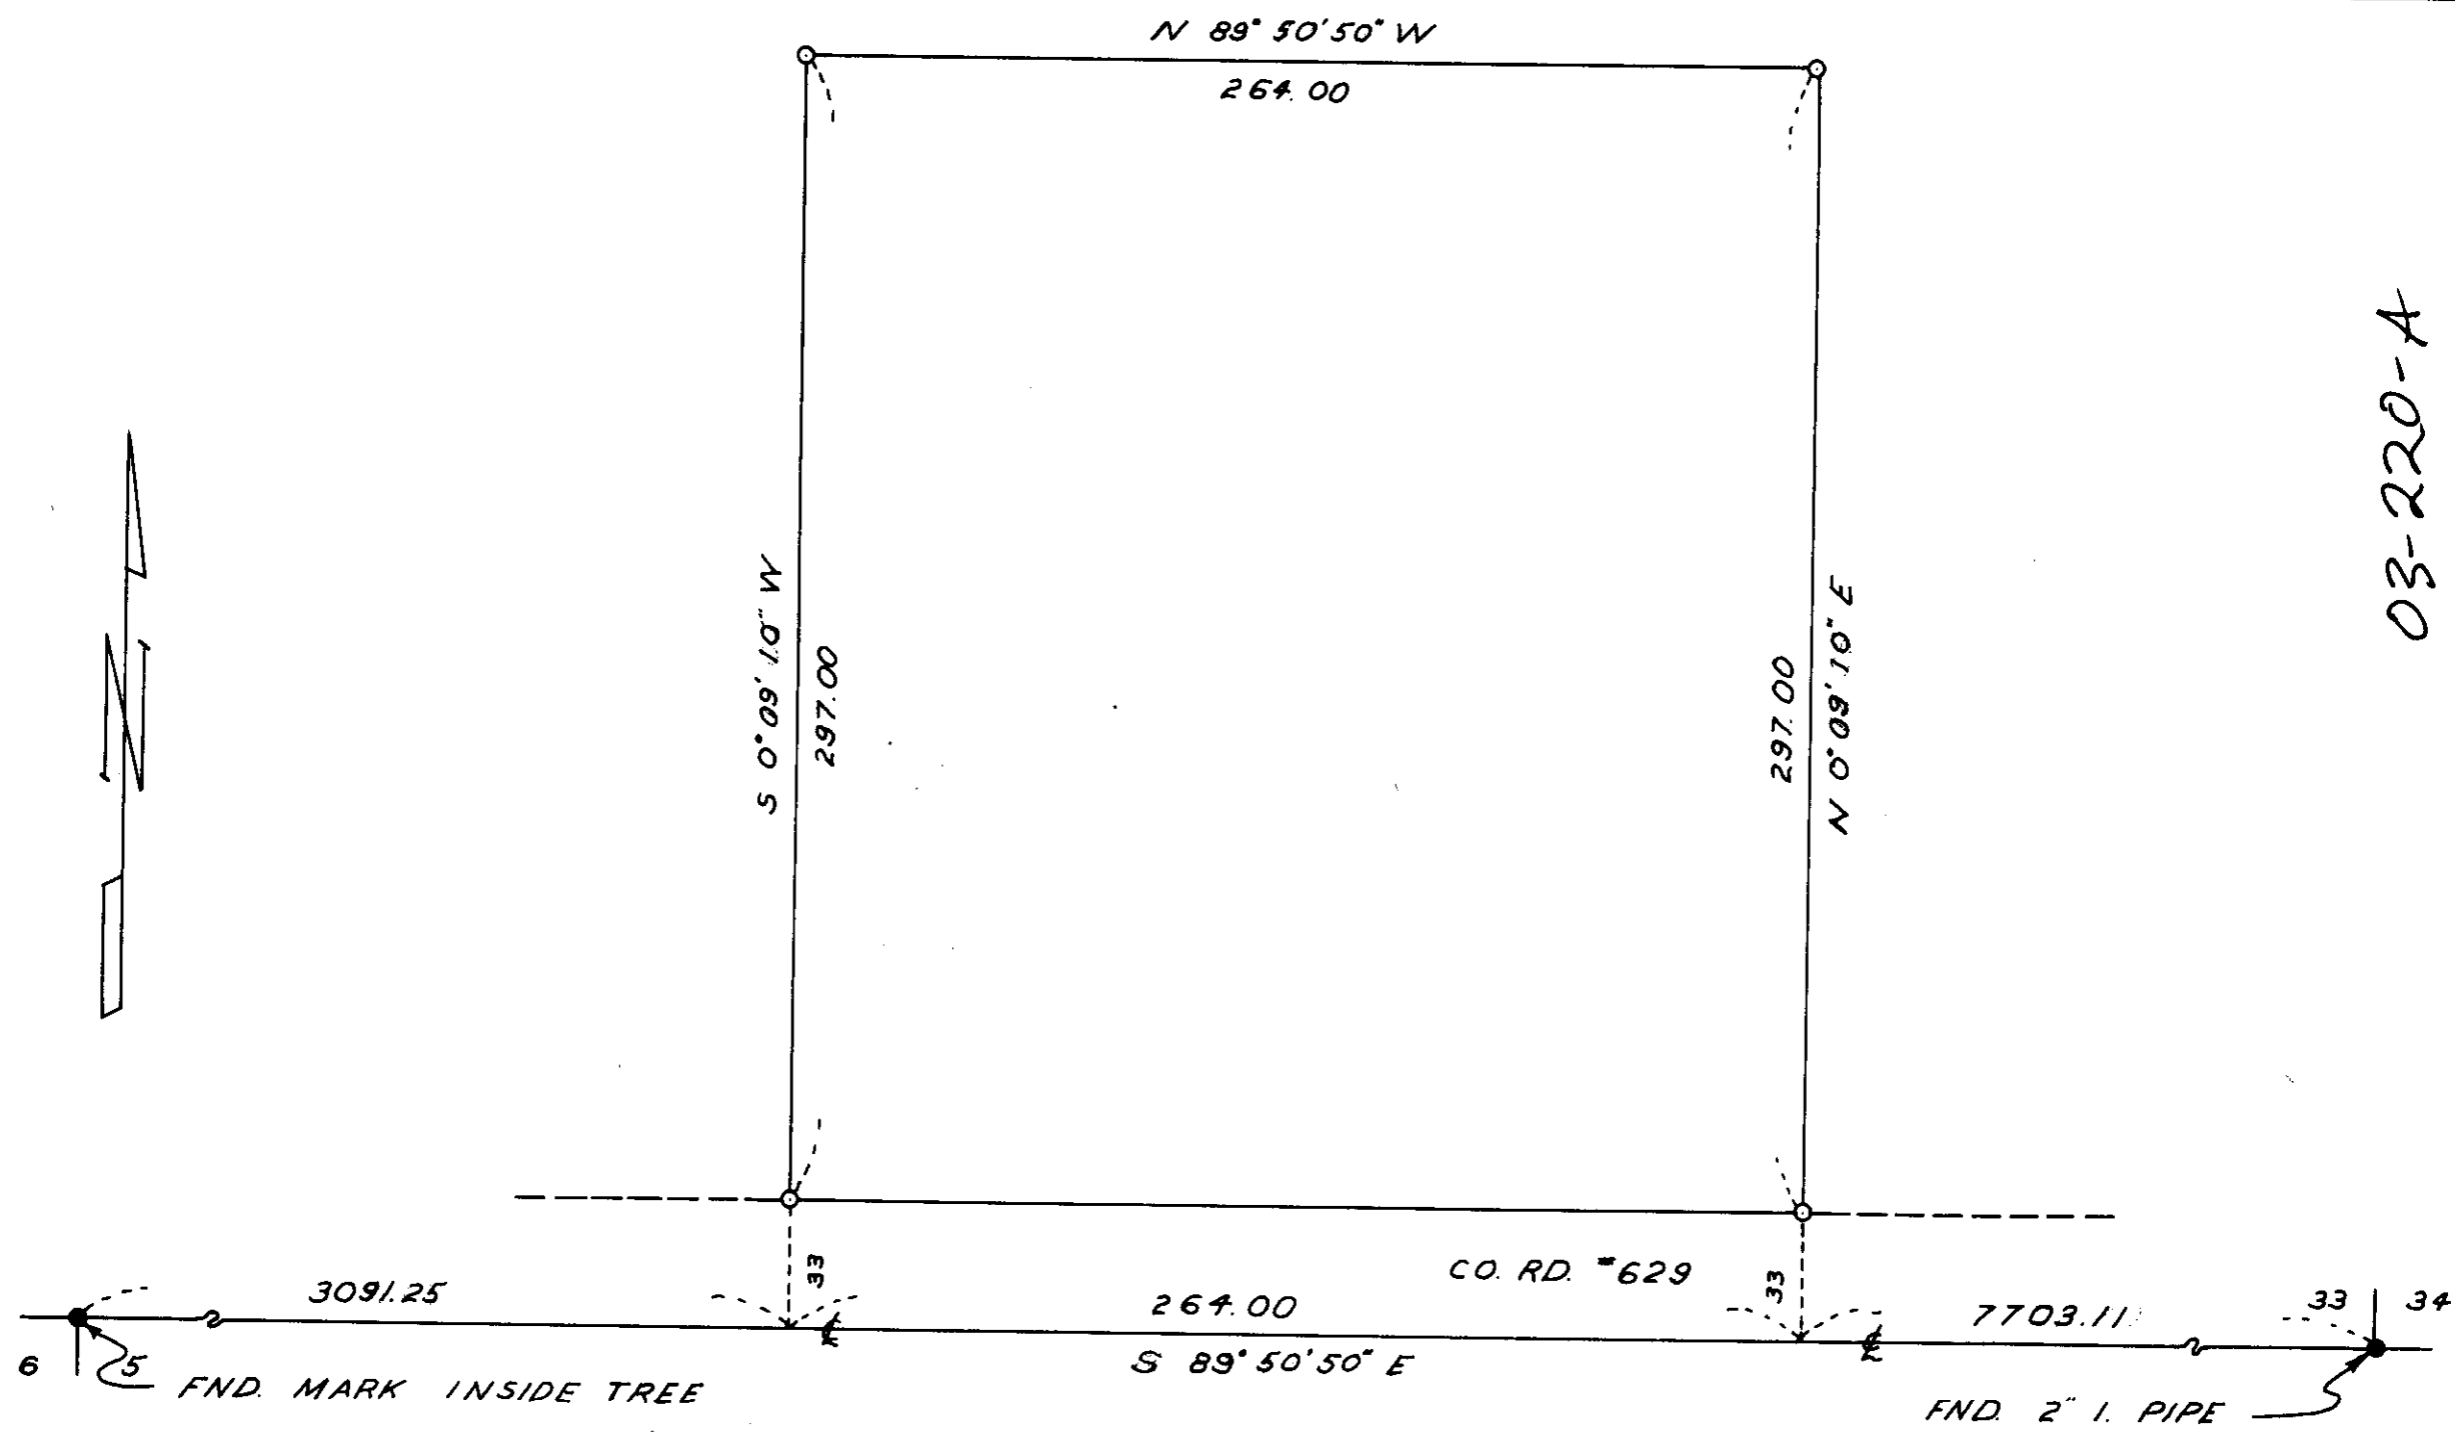

o INDICATES 1/2" I. PIN SET

REGISTERED
OREGON
LAND SURVEYOR

MAY 6, 1966
WAYNE O. HARRIS
346

WAYNE O. HARRIS & ASSOCIATES			
SURVEY FOR			
TRANSAMERICA TITLE COMPANY			
PARCEL IN			
SW 1/4, SE 1/4 OF SECTION 32			
T. 5 N., R. 29 E., W.M.			
SCALE	DATE	DRN. BY	DRNS. NO.
1" = 50'	10-29-69	DHK	69-216-A

03-220-A