


C 1/4, SEC. 34
 FND. 5/8" IRON REBAR
 SET BY ME IN 1977

FND. R.R. SPIKE
 2.2' NORTH &
 0.7' WEST
 ORIGIN UNKNOWN

FND. 3/4" IRON PIPE
 22.28' N & 25.55' E
 OF 1/16 COR.

FND. 2" IRON PIPE
 INITIAL POINT OF
 TROTT'S ACRES

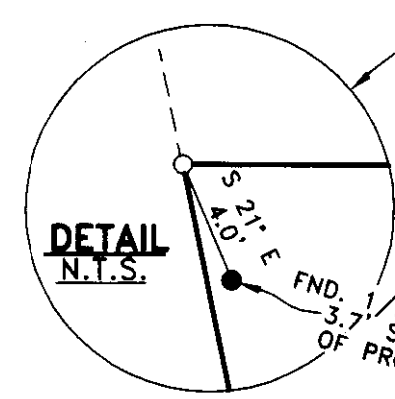

STA 179+50
 FND. 5/8" IRON ROD
 WITH ALUM. CAP
 O.S.H.D.

FND. 1/2" IRON REBAR
 3.7' SOUTHERLY
 OF PROP. COR.

BEARING BASE MY 1993 SURVEY FOR BUTTS
 S 89°49'57" E 2656.04'

N 89°43'47" W 1269.49' (1269.90')

1328.02' (1327.90') TROTTS ACRE

338.86'

U.S. HWY #395
 N 11°20'17" W 406.63'
 151.19'
 381.21'
 255.44'

398.82'
 96.50'
 S 0°05'04" E 418.82'
 (S 0°05'15" E 418.85')

259.51' (259.53')
 N 89°45'12" W

BUTTS
 B. 299, P. 101

NARRATIVE:

THE PURPOSE OF THIS SURVEY IS TO STAKE THE EAST LINE OF THAT TRACT OF LAND DEEDED TO RONALD TRANER ON REEL 298, PAGE 99, UMATILLA COUNTY DEED RECORDS SO A NEW FENCE CAN BE BUILT.

I BASED THIS SURVEY ON ONE I DID FOR BUTTS IN WHICH I SUBDIVIDED THE SE 1/4 OF SECTION 34.

REGISTERED
 PROFESSIONAL
 LAND SURVEYOR

G. Dennis Edwards


OREGON
 JULY 16, 1971
 G. DENNIS EDWARDS
 9 5 1
 RENEWS 12/31/2005

RECEIVED BY
 Umatilla County Surveyor

Date 8-09
 Rec'd By KK
 No. 04-147-A

LEGEND:

- FOUND 5/8" IRON REBAR SET BY ME IN 1993 SURVEY FOR BUTTS UNLESS OTHERWISE NOTED
- SET 5/8"X30" IRON REBAR WITH PLASTIC CAP #951 (000) OF RECORD, MY 1993 SURVEY FOR BUTTS

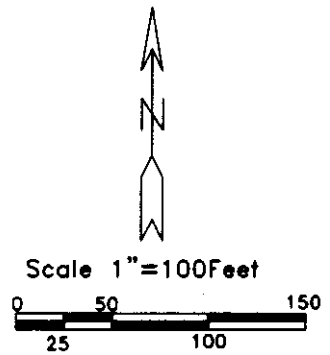

SURVEY FOR ROBERT TRANER
 IN SE 1/4, SEC. 34, T 5 N, R 28 E, W.M.,
 UMATILLA COUNTY, OREGON
 5/11/2004 JOB# S0405081
 EDWARDS SURVEYING P.O. BOX 763
 541-567-3336 HERMISTON, OREGON 97838
 DRAWN BY NJF

04-147-A