

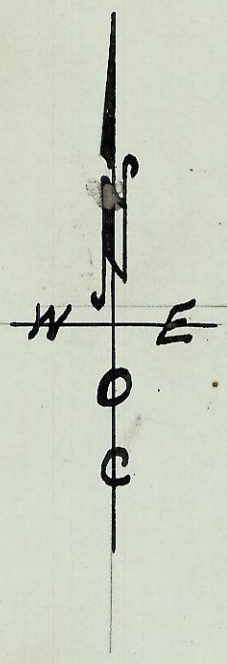



23

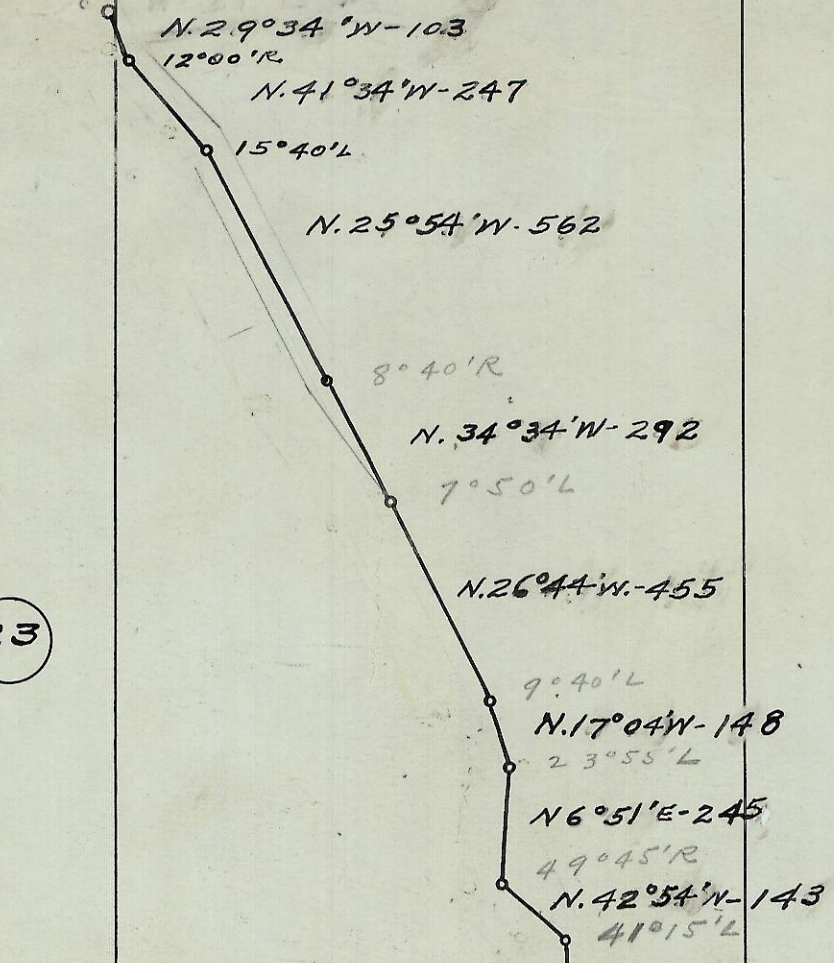

26

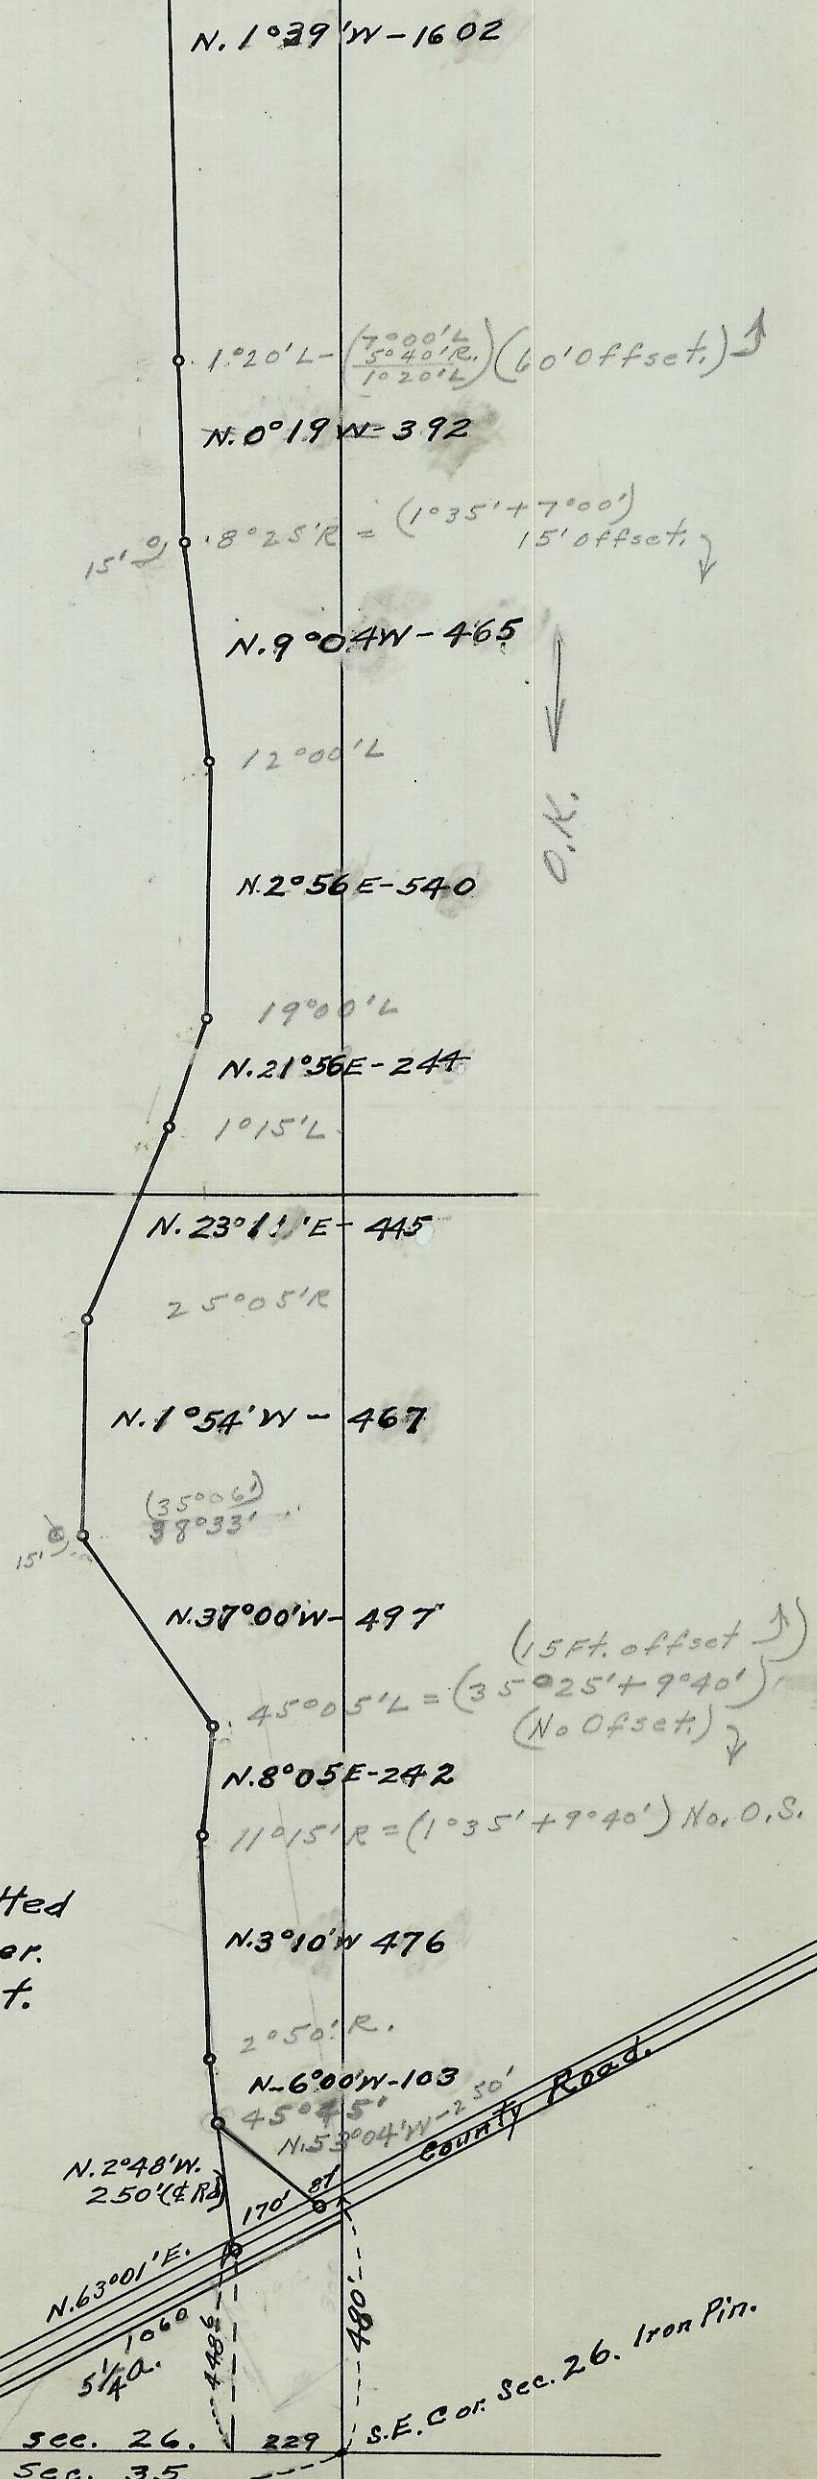

Plat of
 Tract of land located
 in E/2 Sec. 26 and S/2 of E/2
 Sec. 23, T.4N., R. 36 E.W.M.
 surveyed, staked and platted
 Oct. 1949 - By W.E.O. Criger.
 Scale: 1 inch = 400 Feet.

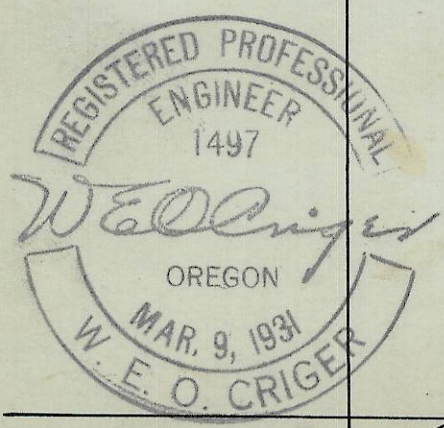

06-77-A

Weston Mountain