


End 1 1/2" I.P.
For W 1/4 Cor
Sec. 1
Set 3/4" I.P.

CO. R.D. NO. 604
66' R/W

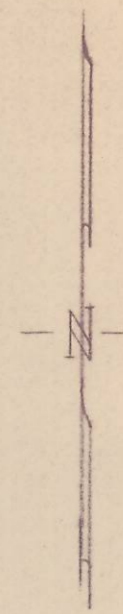

End 3/4" I.P.

End 3/4" I.P.
For So. 1/4 Cor
Sec. 1

End 2" I.P.
For SW Cor
Sec. 1

REGISTERED
OREGON
LAND SURVEYOR

Ralph P. Thompson
MAY 13, 1960
RALPH P. THOMPSON
506

ICC

⊙ Indicates Monuments Found
● Indicates Property Corners
Set - 1/2" x 24" I.P.'s

Property Survey For
ELVIS SMITH
In SW 1/4 Sec. 1, T. 4 N. R. 28 E. W. M.
Date: 3-23-64 Scale: 1" = 200'

06-386-A

R. P. THOMPSON
REGISTERED PROFESSIONAL LAND SURVEYOR
13 & E. COURT AVE., PENDLETON, OREGON