


Part of  
 NW $\frac{1}{4}$  Section 3 T.5N, R.35E.W.M.  
 Scale: 1 inch = 200 Feet.

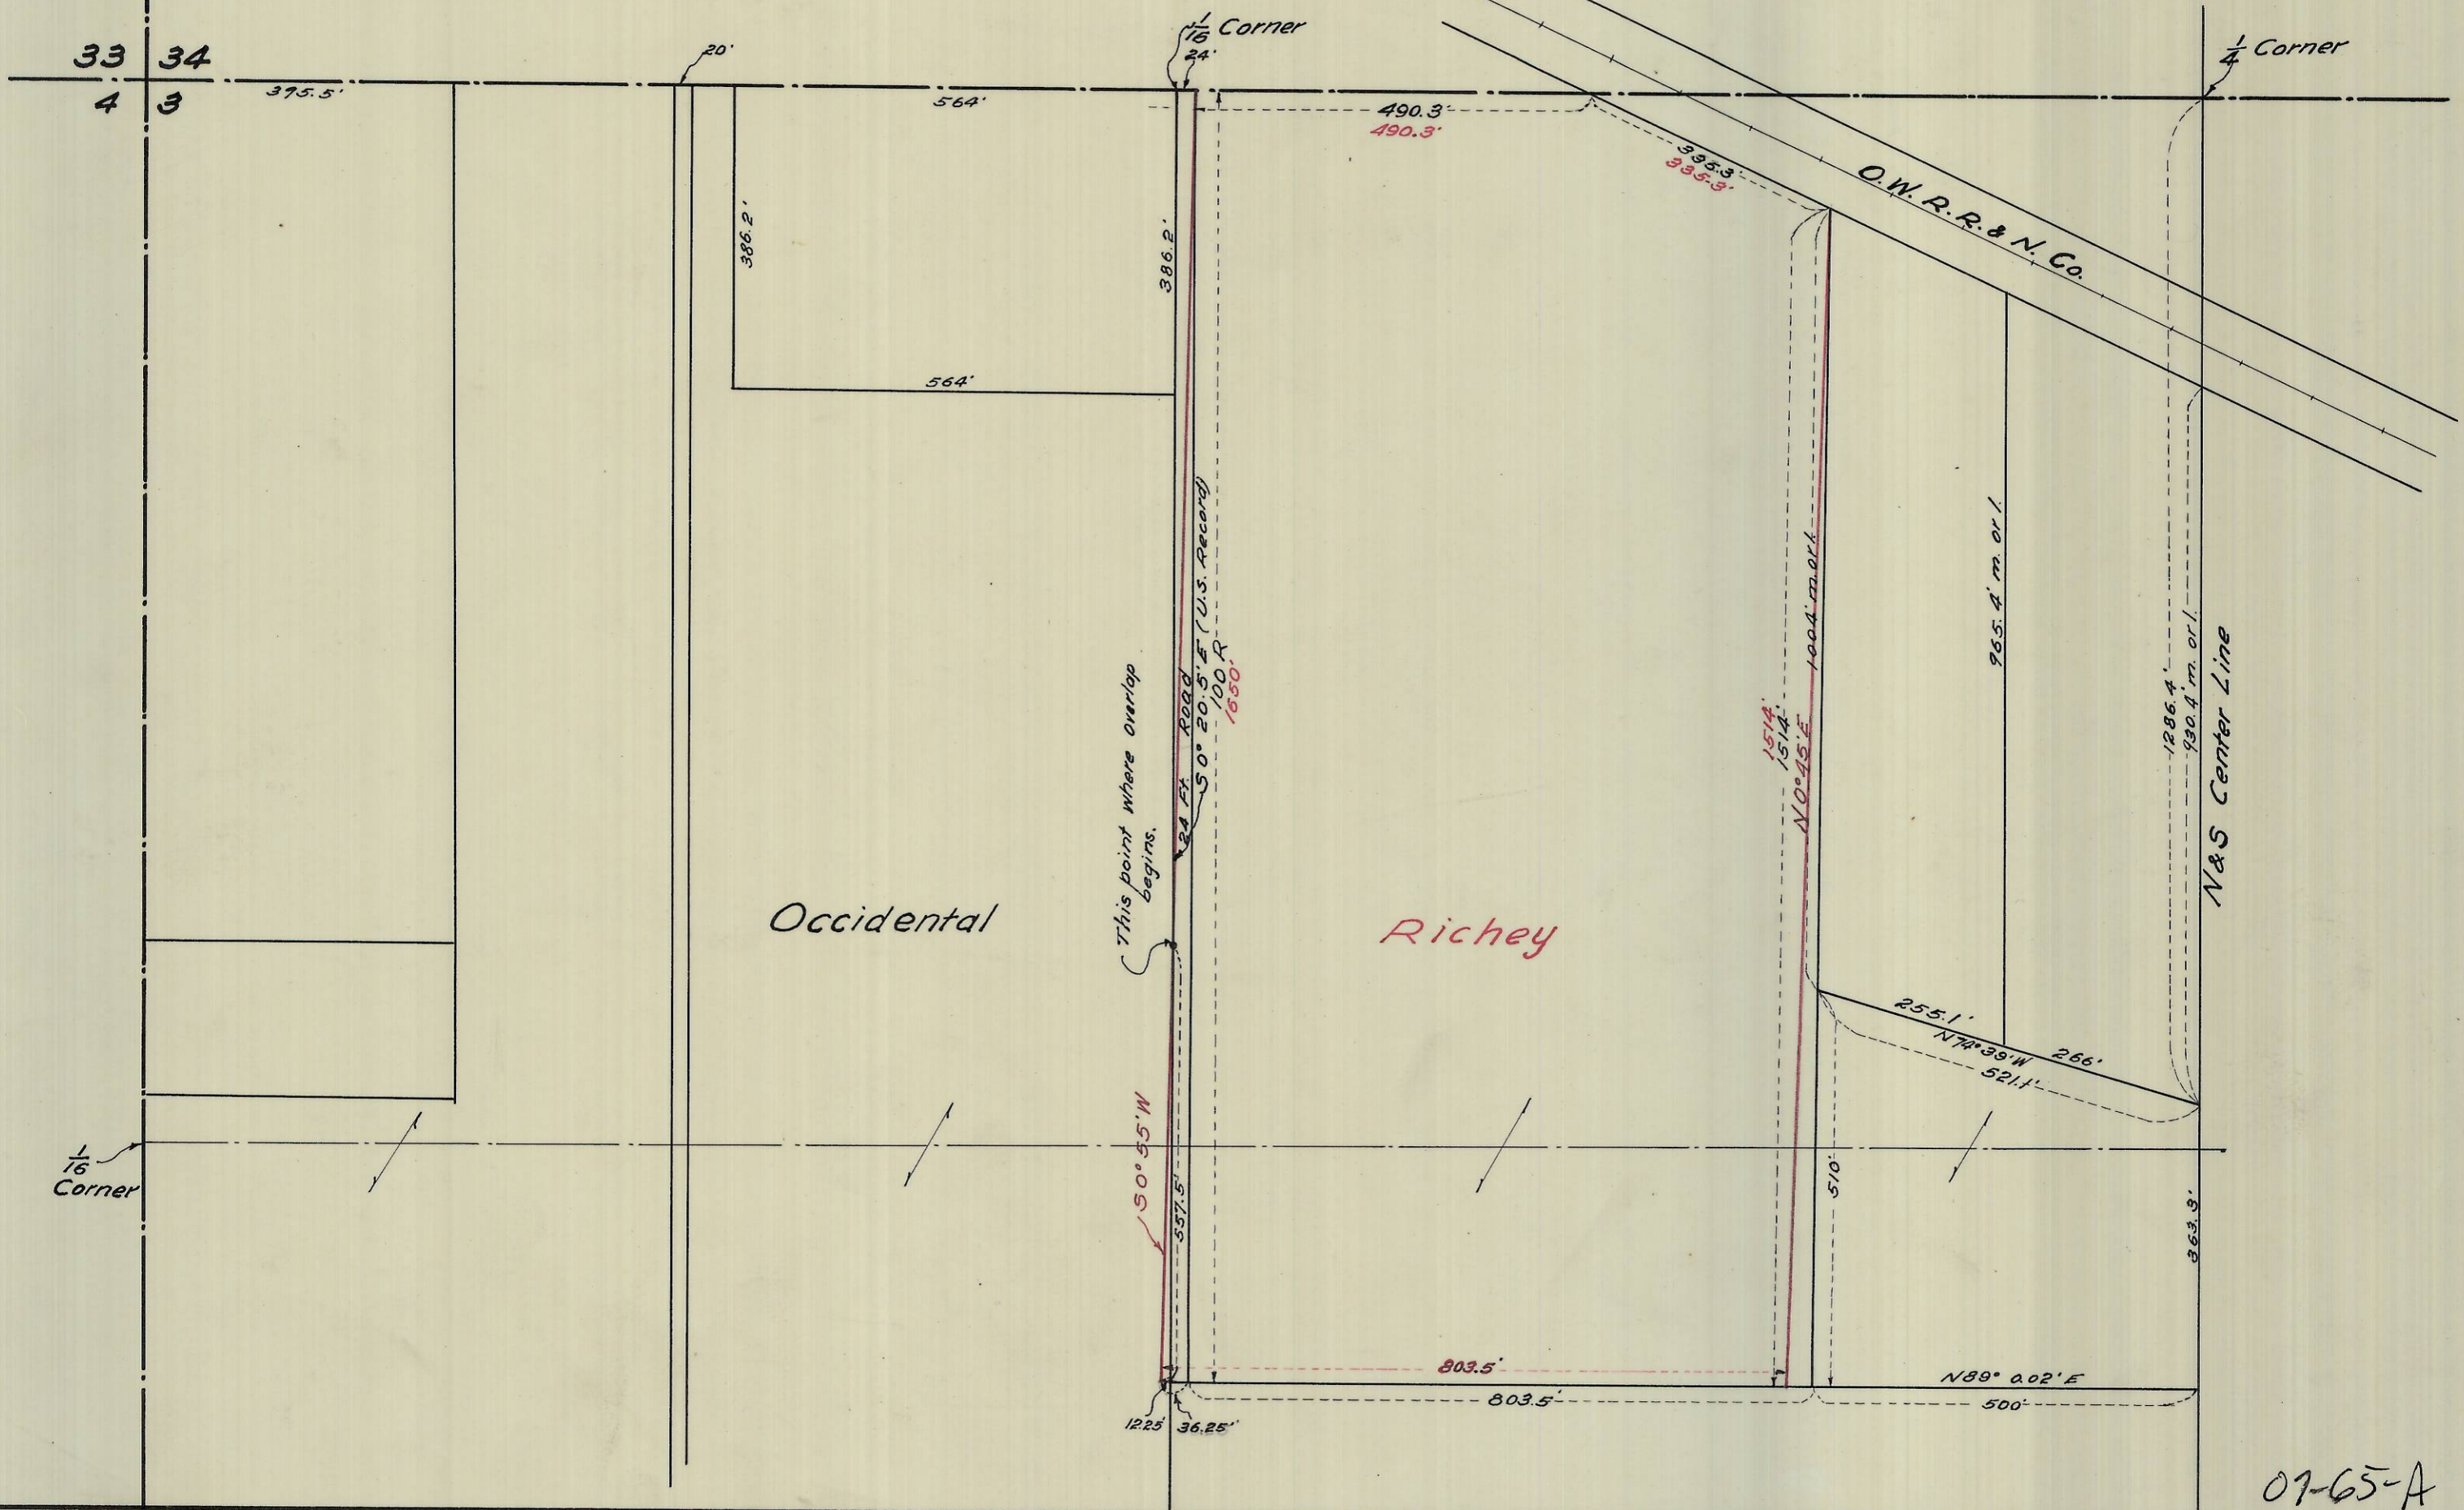

07-65-A