


SURVEYOR'S NARRATIVE:

THE PURPOSE OF THIS SURVEY IS TO STAKE THE NORTH-SOUTH CENTER LINE OF THE SOUTHWEST QUARTER OF SECTION 30 SO A PIVOT CAN BE LOCATED IN THE WEST HALF OF SAID SOUTHEAST QUARTER.

I BASED THE BEARINGS ON MY 2005 COUNTY MONUMENTATION SURVEY. A TOPCON HYPER + G.P.S. WAS USED IN REAL TIME TO CONDUCT THIS SURVEY.



Scale 1"=600 Feet

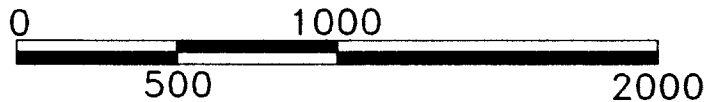

LEGEND:

- MONUMENTS FOUND AS NOTED
- SET 5/8"X30" IRON REBAR WITH PLASTIC CAP #951
- ⊙ COMPUTED LOCATION

REGISTERED
PROFESSIONAL
LAND SURVEYOR

G. Dennis Edwards

OREGON
JULY 16, 1971
G. DENNIS EDWARDS
9 5 1

RENEWS 12/31/2009

SURVEY FOR CHARLES BLOODSWORTH
IN E 1/2, S 1/4, SEC. 30, T 5 N, R 29 E,
W.M., UMATILLA COUNTY, OREGON
02/20/2008 JOB# S0802022
EDWARDS SURVEYING P.O. BOX 763
541-567-3336 HERMISTON, OREGON 97838
DRAWN BY JMC

RECEIVED BY

Umatilla County Surveyor

Date 4-08

Drawn by KK

Job # 08-71-A