

Sketch of Main Street Milton Oregon.

Showing District Macadamised


Width of Macadam = 68'

CROWN = 1.50'

Parabolic curve

Jan. 27 1912

Willard Bradley.

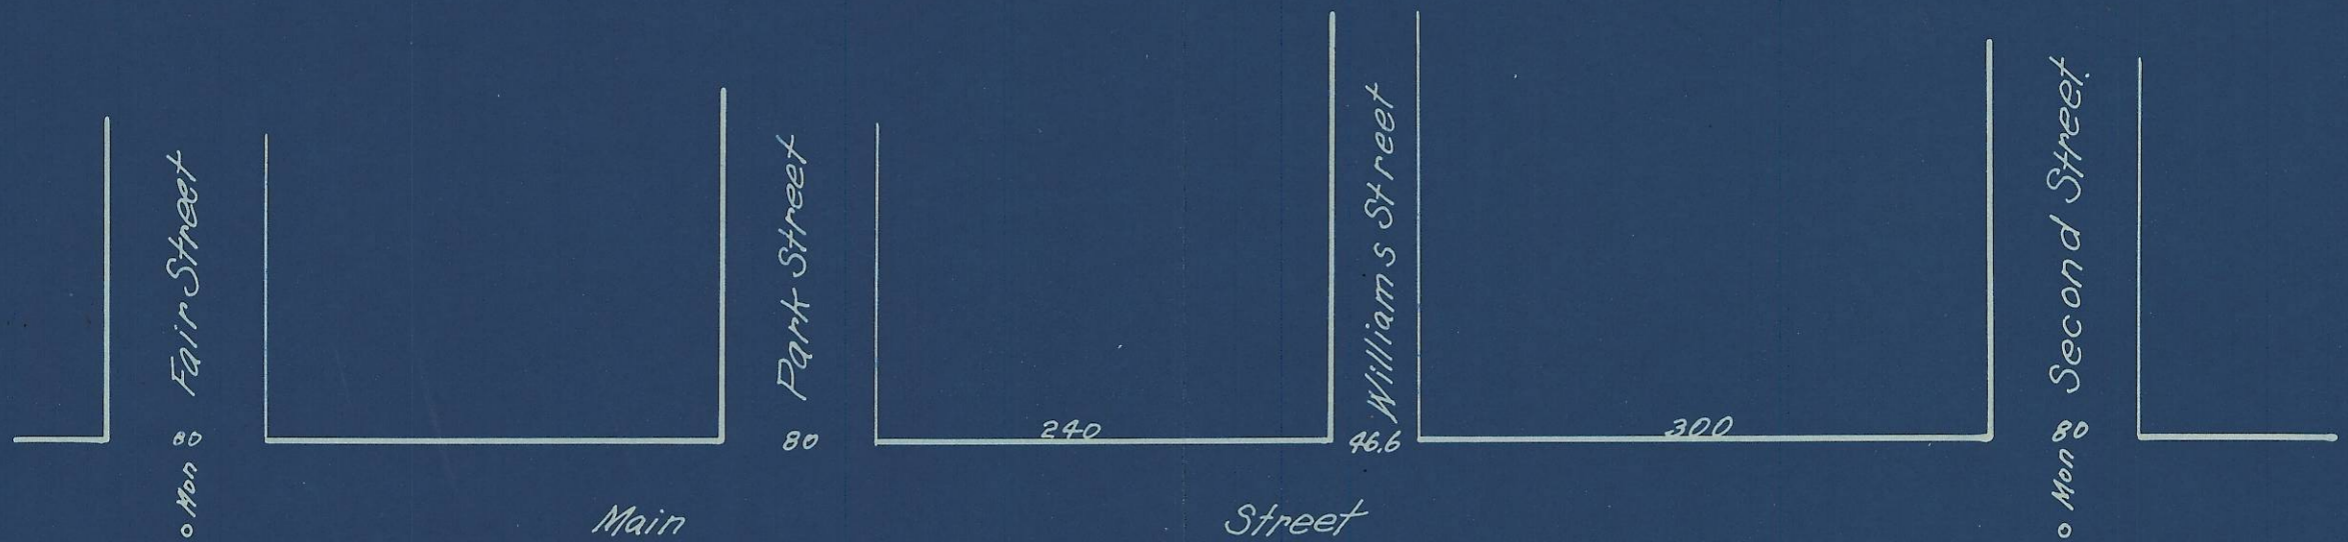

Note: This is a copy of the plat found at page 124 of the Milton City Plat Book at Milton Oregon. However this plat does not appear on the public official records of Umatilla County Oregon.

Hartman Abstract Company
Pendleton Oregon

11-156-A
(5N 35 01 CD)

5N35 1CD