6N3524D

302

4-3

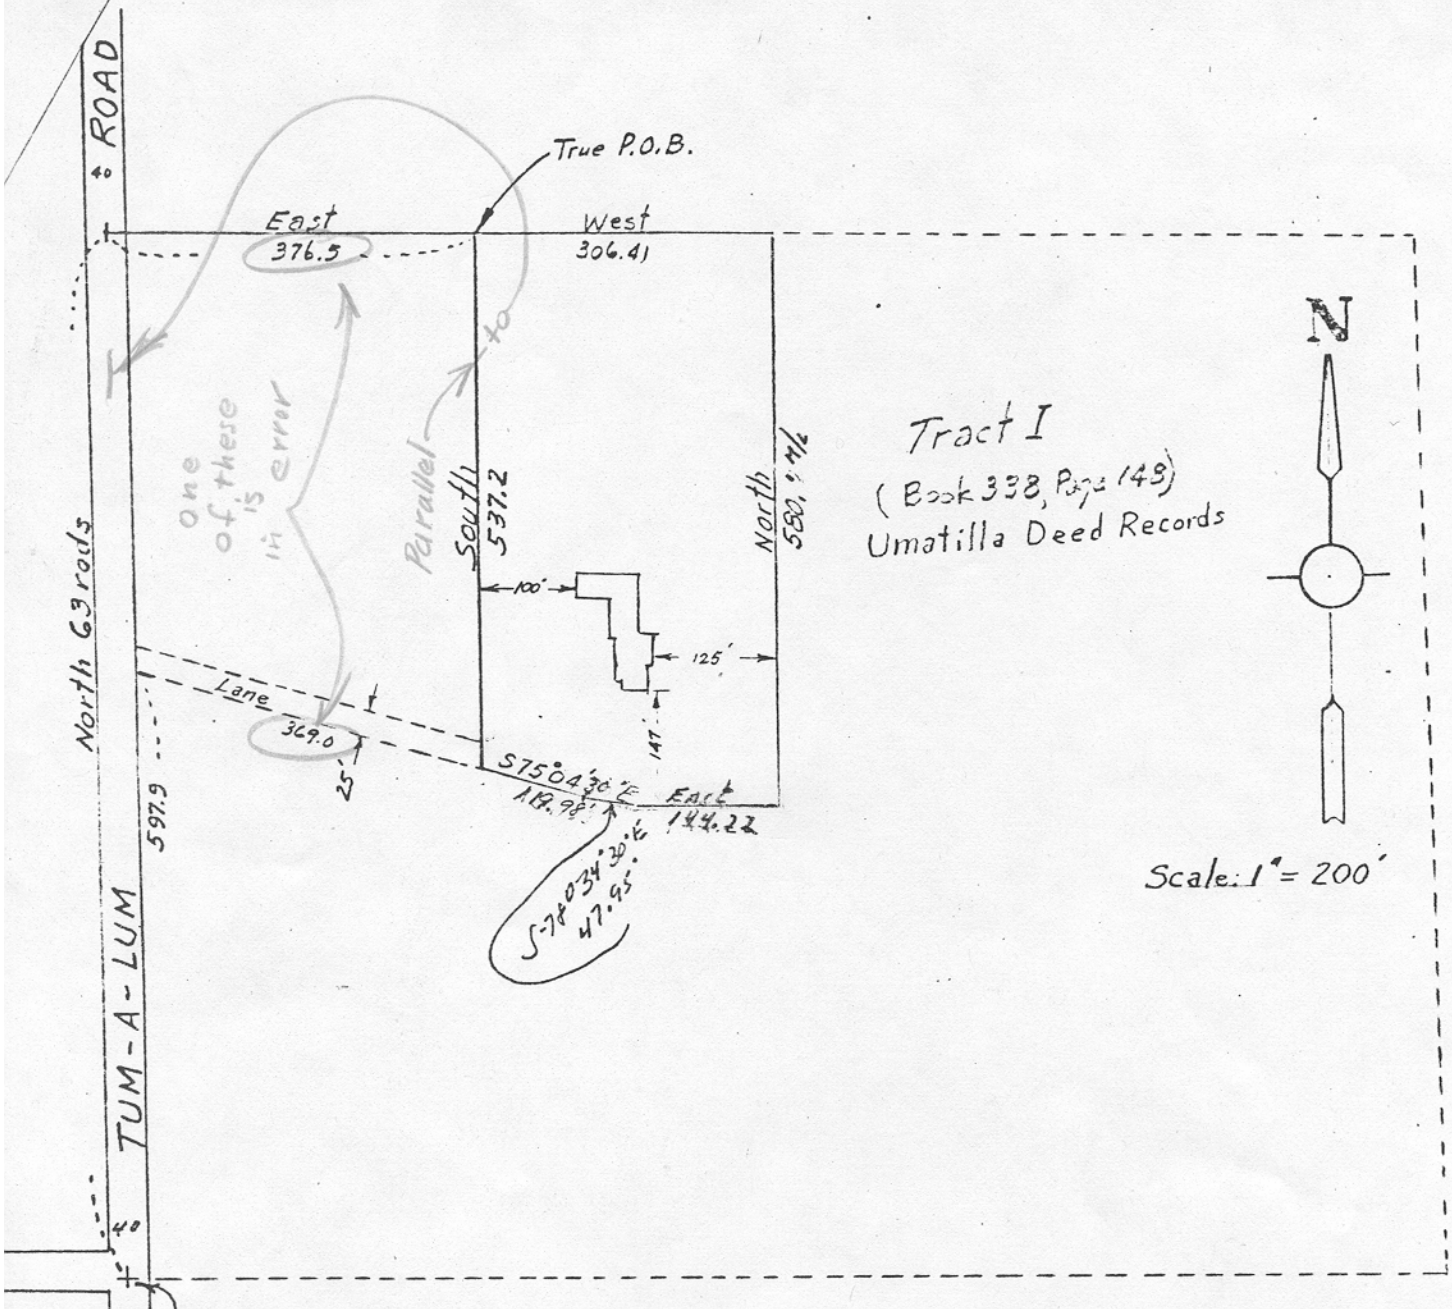

Southwest corner of
the Northwest quarter
of the Southeast quarter
of Section 24, T.6 N., R.35 E.

6N3524D

ALLEN J. LOMMASSON
Registered Professional Surveyor
258 EACAN
WALLA WALLA, WASHINGTON

Survey for
W. L. Unterseher (24)

7/23/76

RECEIVED
JUL 30 1976
PIONEER TITLE CO.

TL 302

6N3524D 13