


**LEGEND:**  
 ● MONUMENTS FOUND AS NOTED  
 ○ SET 5/8"X30" IRON REBAR WITH PLASTIC CAP # 951 (000) OF RECORD PLAT OF "PENDER 1ST ADDITION" & "NEWPORT ADD"

**NEWPORT ADDITION**

**BLOCK 1  
PENDER 1ST ADD.**

**RECEIVED BY**  
 Umatilla County Surveyor  

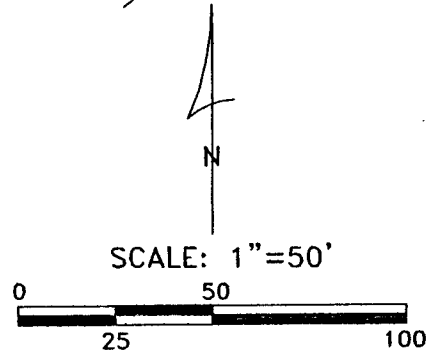

SE SIXTH STREET

SE SEVENTH STREET

**NARRATIVE:**

THE PURPOSE OF THIS SURVEY IS TO DO A BOUNDARY LINE ADJUSTMENT TO ADD THE SOUTH 103.85 FEET OF LOT 22 "PENDER FIRST ADDITION" TO THAT TRACT OF LAND WHICH WAS DEEDED TO JERRY AND WILMA WARD ON REEL 308, PAGE 1305, UMATILLA COUNTY DEED RECORDS. SAID WARD TRACT IS A PORTION OF LOT 13 OF "NEWPORT ADDITION".

THE BEARINGS AND THIS SURVEY ARE BASED ON BURNETT'S SURVEY OF "PENDER FIRST ADDITION" IN WHICH HE SURVEYED A PORTION OF "NEWPORT ADDITION".

REGISTERED  
PROFESSIONAL  
LAND SURVEYOR

*G. Dennis Edwards*

OREGON  
JULY 16, 1971  
G. DENNIS EDWARDS  
951  
RENEWS 12/31/2003

BOUNDARY LINE ADJUSTMENT FOR WILLIAM SATHER  
 LOT 22, BLOCK 1, "PENDER FIRST ADDITION",  
 CITY OF HERMISTON, UMATILLA COUNTY, OREGON  
 IN SW 1/4, SEC. 11, T 4 N, R 28 E, W.M.  
 5/15/2002 JOB# S0006134A  
 EDWARDS SURVEYING P.O. BOX 763  
 541-567-3336 HERMISTON, OREGON 97838  
 DRAWN BY NJF