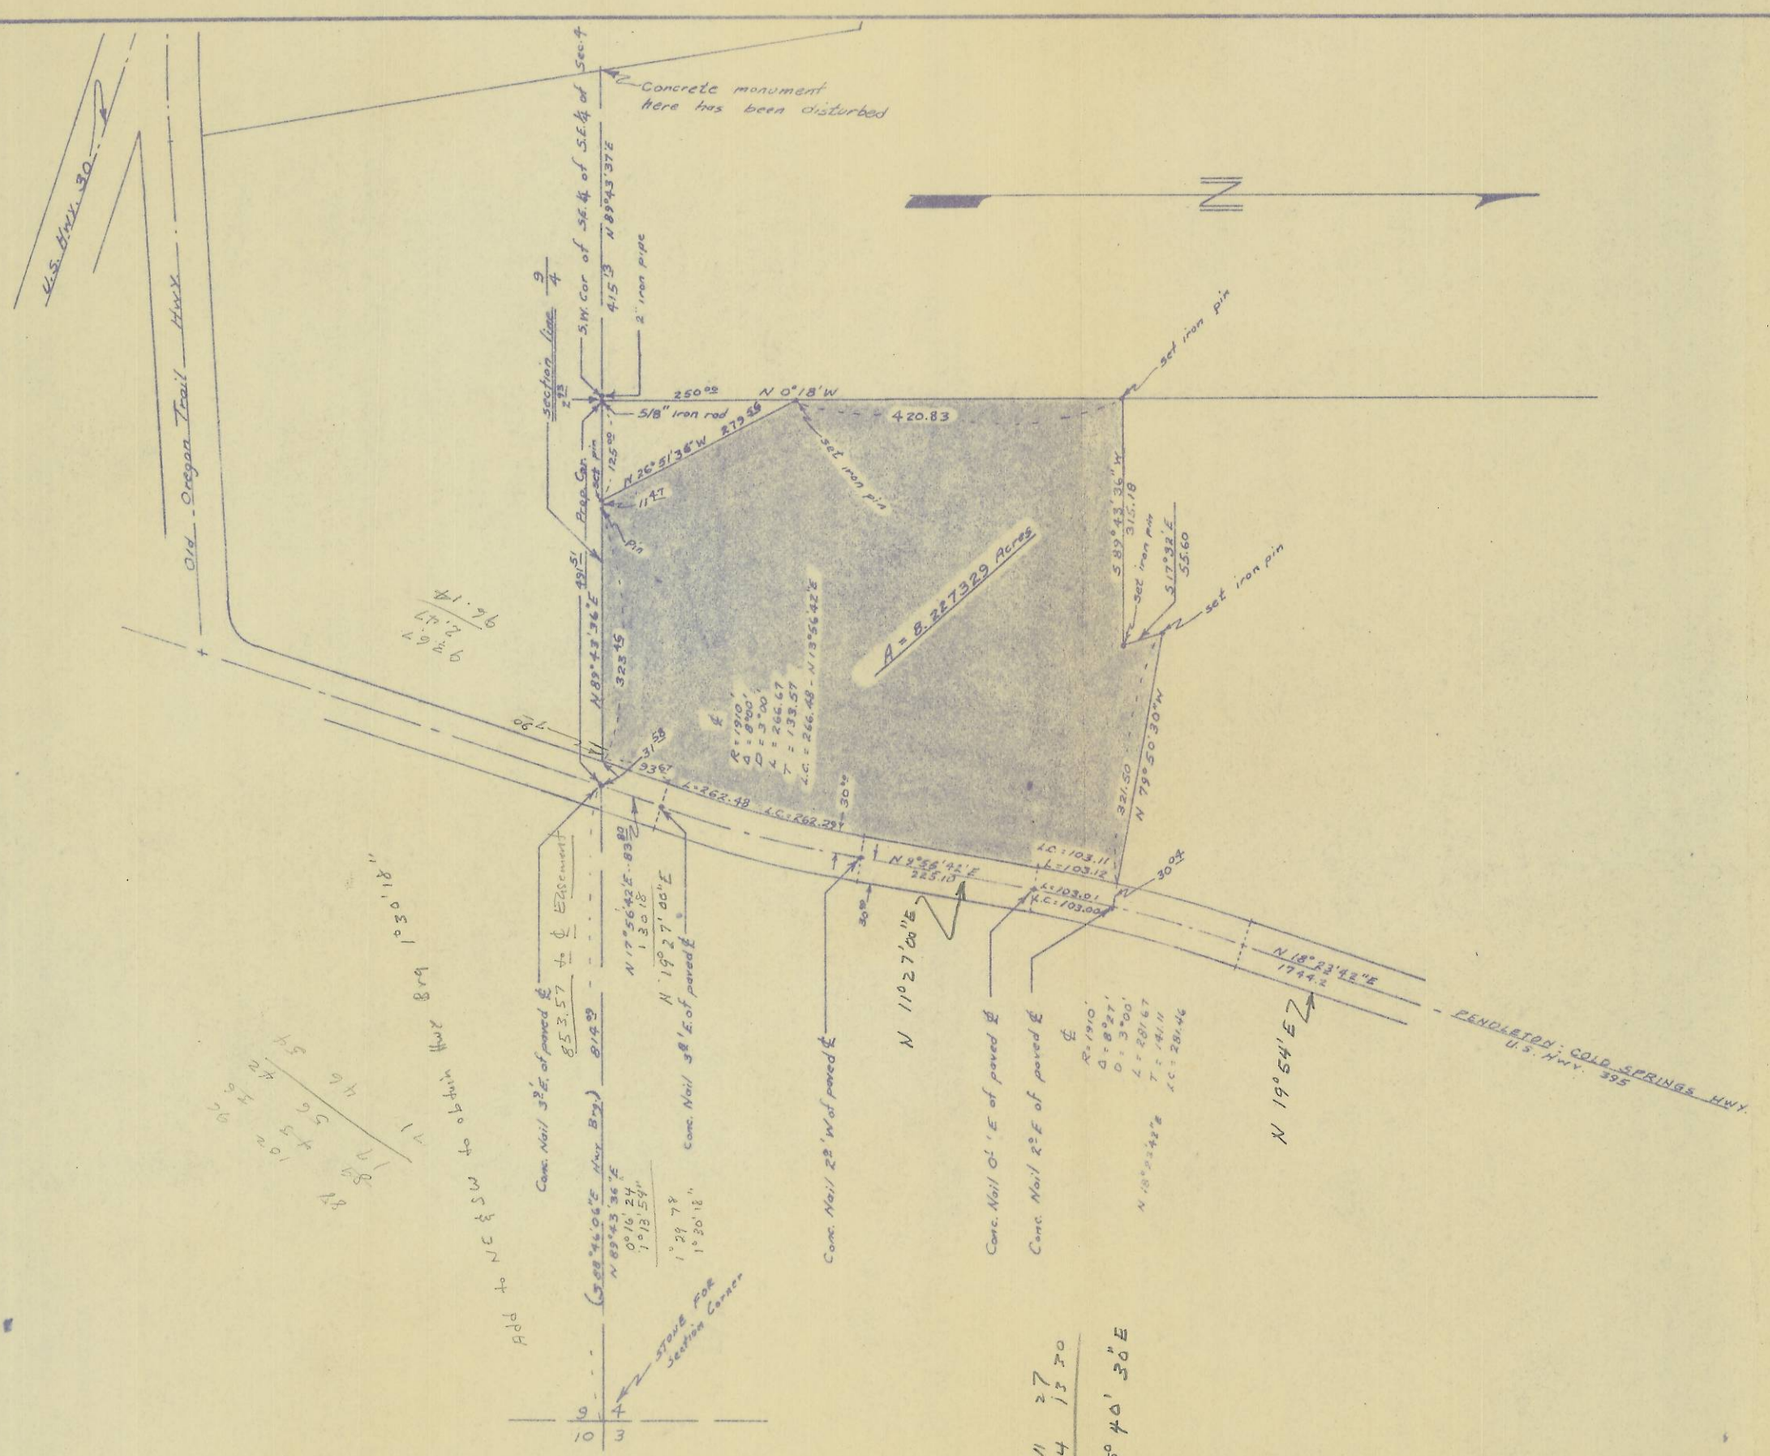

REGISTERED PROFESSIONAL ENGINEER
3758
Stanley G. Wallulis
OREGON
OCT. 22, 1954
STANLEY G. WALLULIS

B-18-A

LAND SURVEY FOR
ED LORREN

Scale 1" = 200'	Date: 2-25-66	By: S.G.W.

WALLULIS & STAEBLER
CONSULTING ENGINEERS
213 S.W. EMIGRANT
P.O. Box 91
Pendleton Oregon

2N32 4