




SCALE: 1" = 100'
DATE: 4-17-72

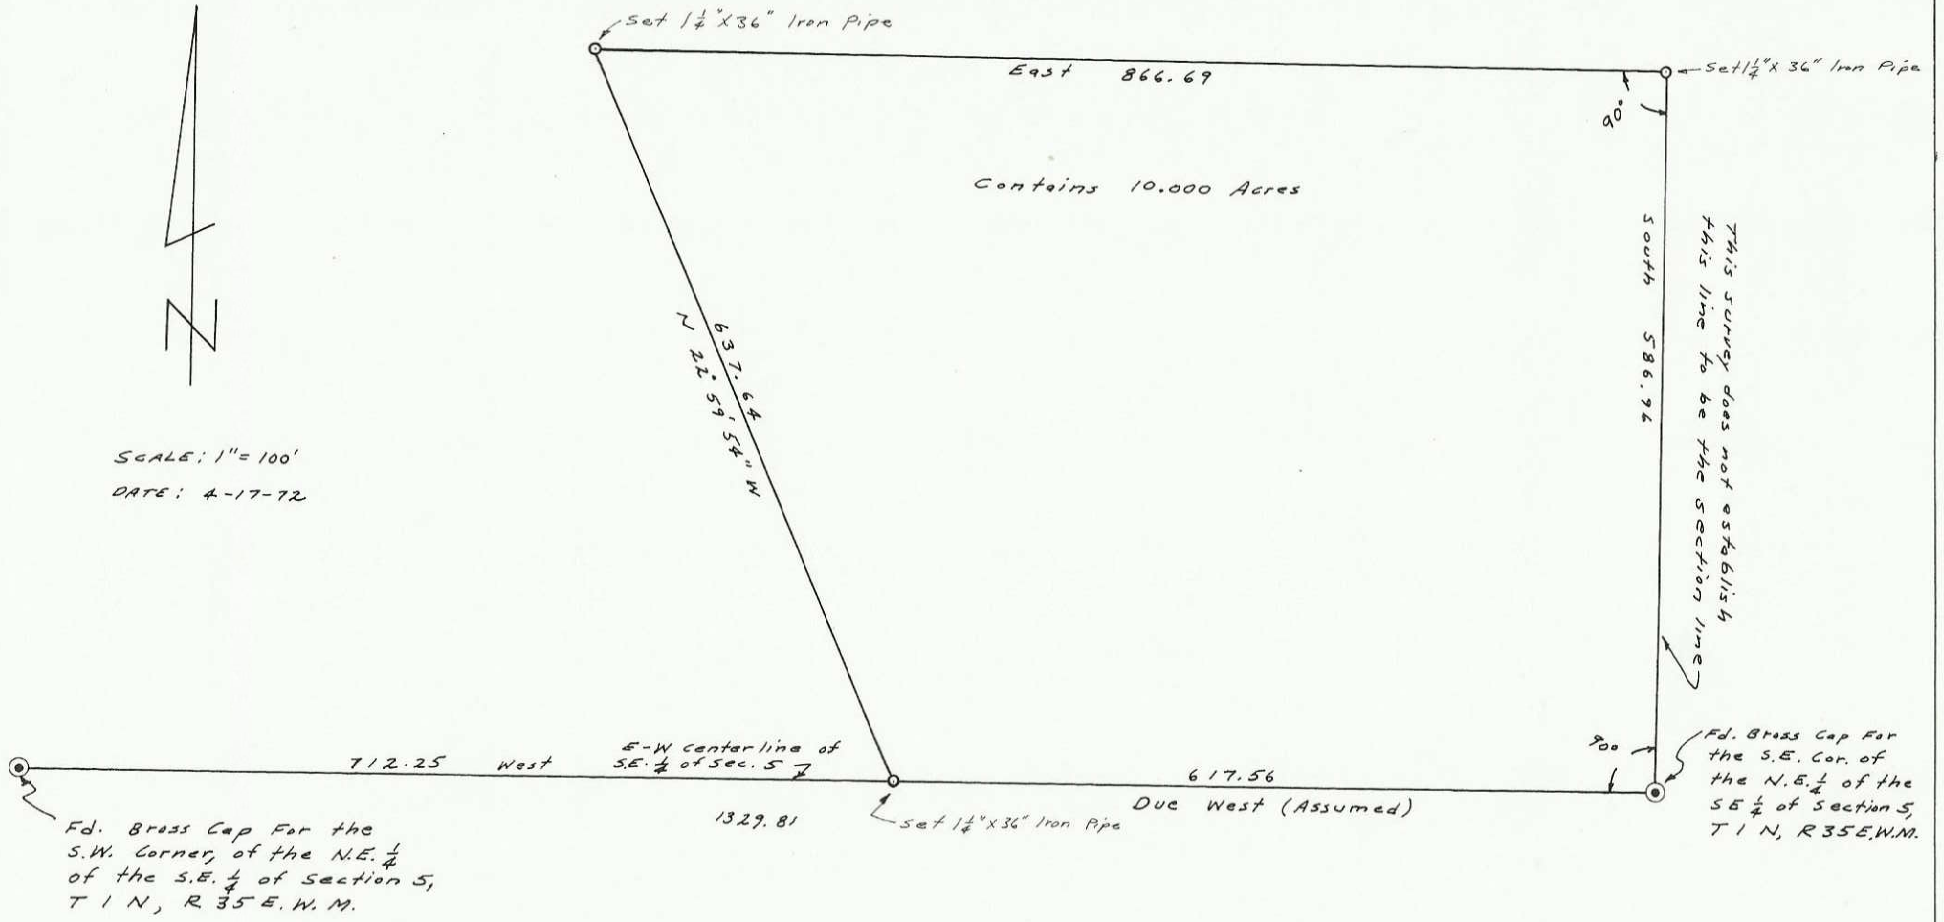

Fd. Brass Cap For the S.W. Corner, of the N.E. 1/4 of the S.E. 1/4 of Section 5, T 1 N, R 35 E. W. M.

This survey does not establish this line to be the section line

Fd. Brass Cap For the S.E. Cor. of the N.E. 1/4 of the S.E. 1/4 of Section 5, T 1 N, R 35 E. W. M.



LAND SURVEY FOR JACK KINNAMAN PENDLETON OREGON SECTION 5, T 1 N, R 35 E. W. M.	
SCALE: 1" = 100'	DATE: 4-17-72
DONALD L. STAEBLER CONSULTING ENGINEER P.O. Box 91 PENDLETON, OREGON	