


Survey control based on James J. Higgins survey of Section 24, T4N, R28E, W.M. for R.G. Beebe, in 1954 on file in Co. Surveyor's Office.

I-82-A

SURVEY PLAT OF ACREAGE TRACTS FOR GLEN ROHDE IN NW 1/4 SEC. 24 T 4N, R28E. W.M. SCALE 1" = 200' 6/30/73

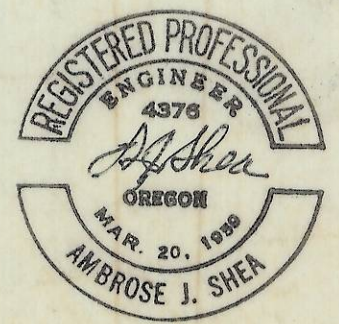

Legend
 Points Found as noted □
 Points Set 1/2" x 24" Iron Pins ○

I-82-A