


LEGEND

- - FND 3/8" IRON PIN
- - SET 1/2" IRON PIN
- - SET R.R. SPIKE
- FENCE
- ⊙ - MAN HOLE

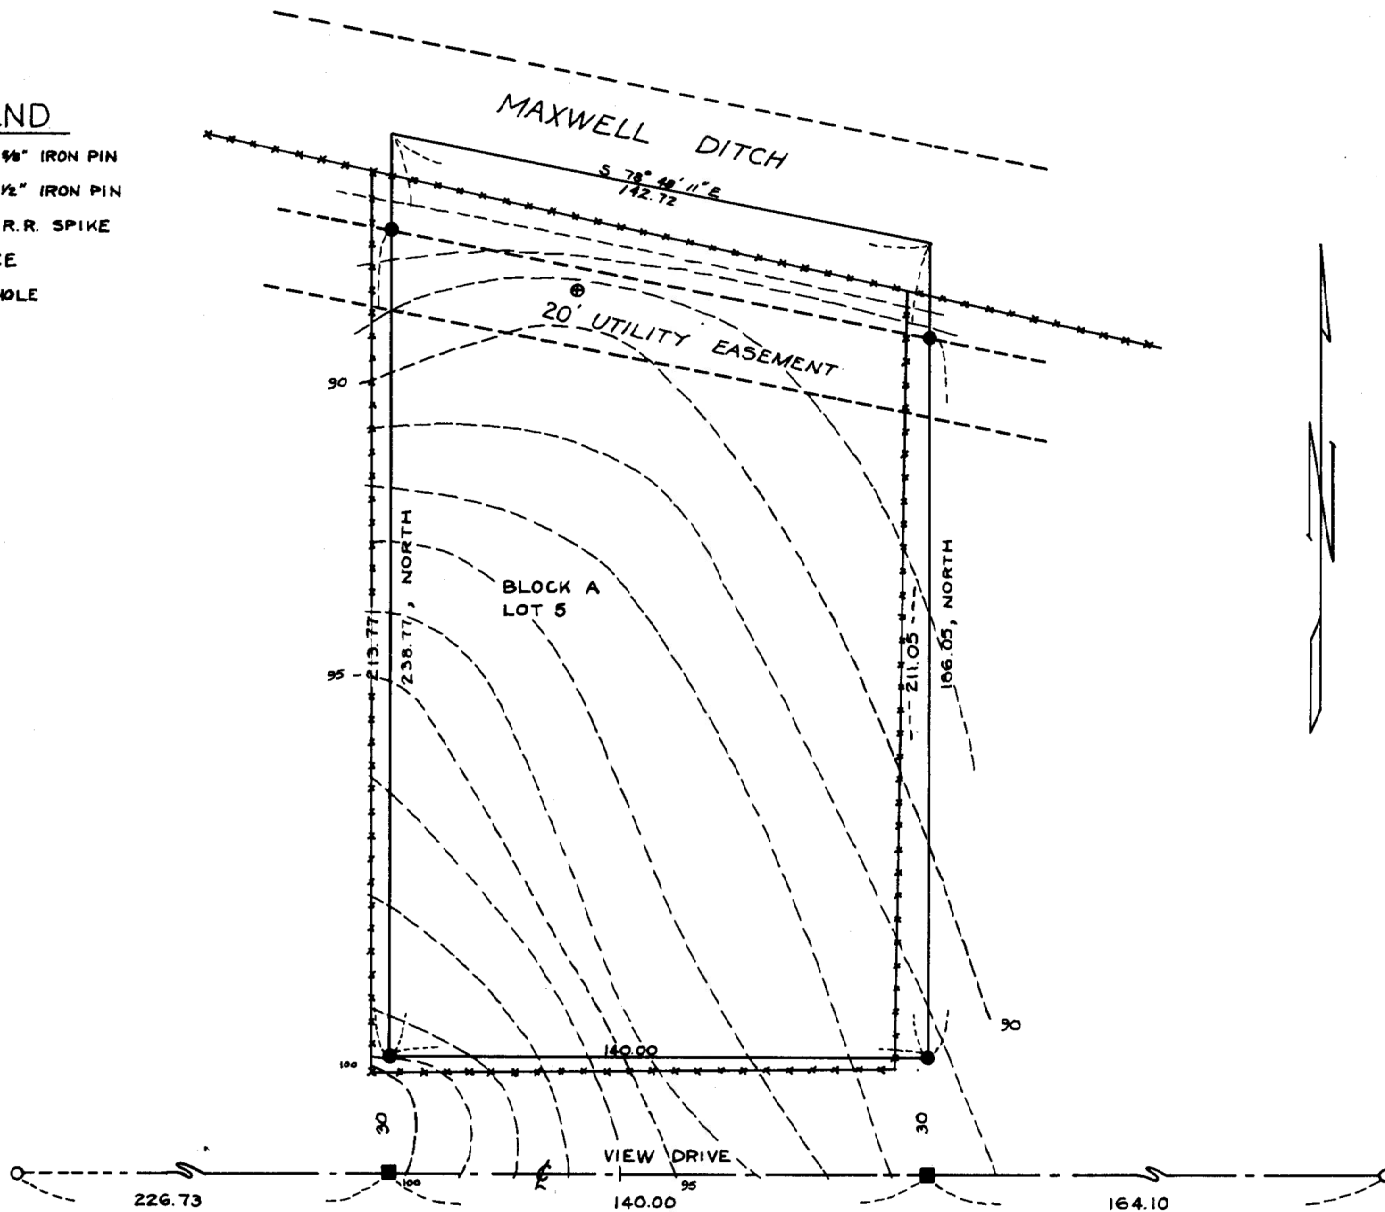

REGISTERED
PROFESSIONAL
LAND SURVEYOR
David H. Krumbein
OREGON
JULY 17, 1970
DAVID H. KRUMBEIN
933

40 28 14 AC

J-95-A

SURVEY FOR		WAYNE HARRIS CO. INC.		
G. K. HALL		ENGINEERS - SURVEYORS PENDLETON, OR.		
SCALE	1" = 30'	DRN. BY	OWB	DRNG. NO
DATE	7-7-75	CHKD. BY	DHK	75-74B