

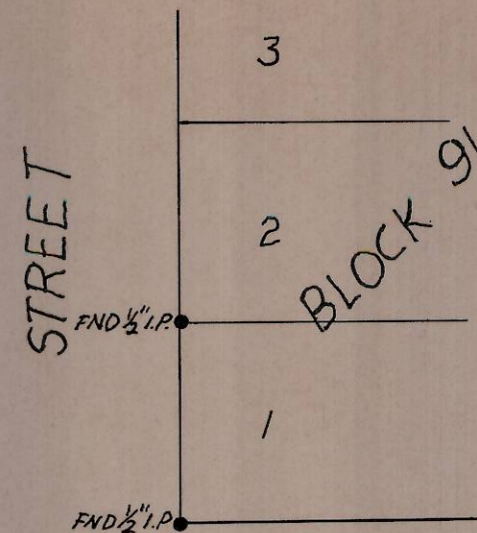



STREET

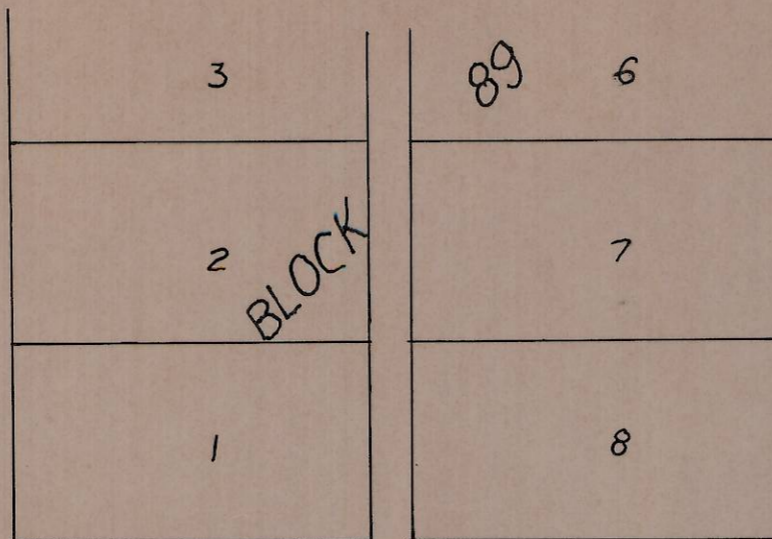




K STREET

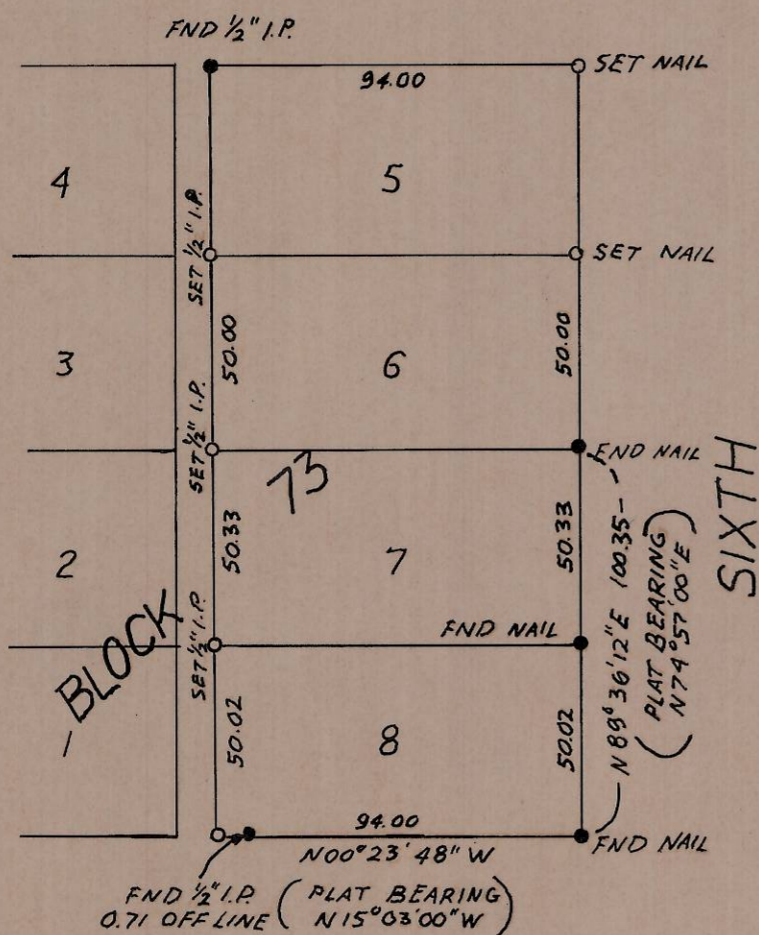

SIXTH

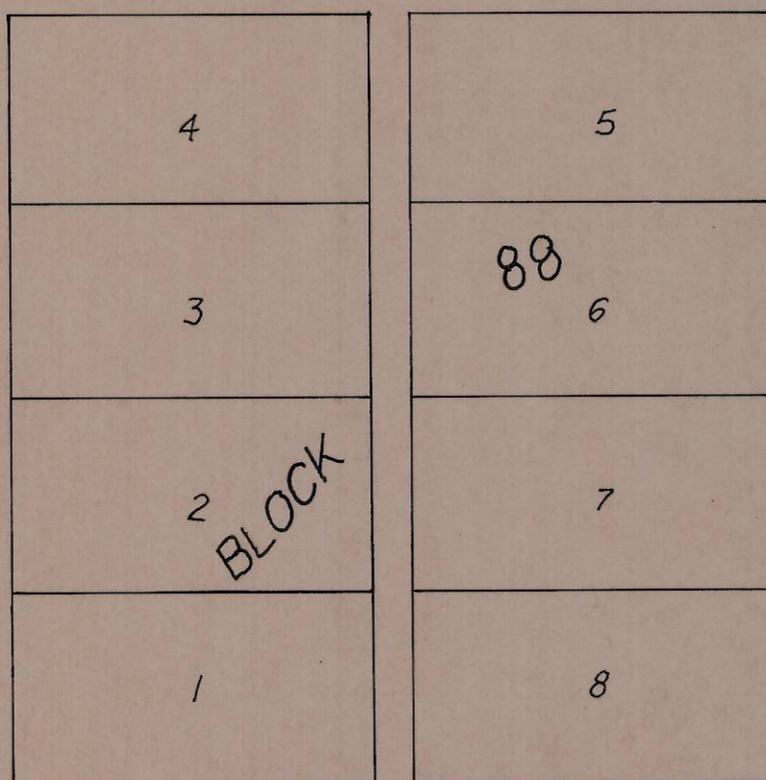

SEVENTH

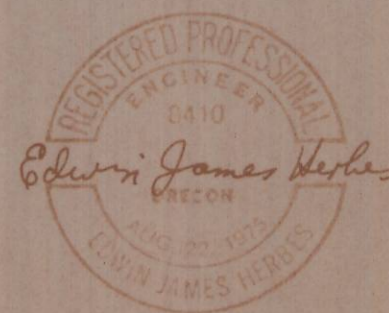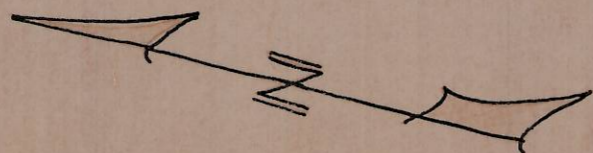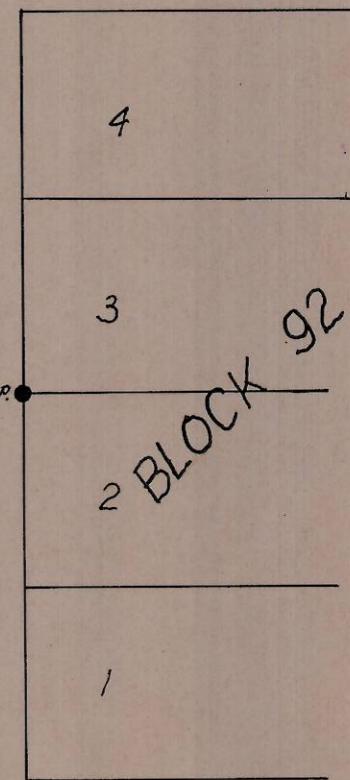

J-123-A

SURVEY FOR		WAYNE HARRIS CO. INC.			
SCROTH REALTY		ENGINEERS - SURVEYORS		PENDLETON, OREGON	
SCALE	1" = 50'	DRN BY	JKM	DRNG NO	
DATE	9-25-75	GKD BY	GTP	75-356A	
BLOCK 73, WARDWELL'S ADD'N, UMATILLA, OREGON					