

L-67-A



T.2N.R.32E.

S.89°25'10" E. Record Bear

22-23

Find 1/2" I.P. ON  
E-W C of Sec.  
N-W Cor. Selves  
Property.

Find 1/4 Cor.  
3/4" I.P.

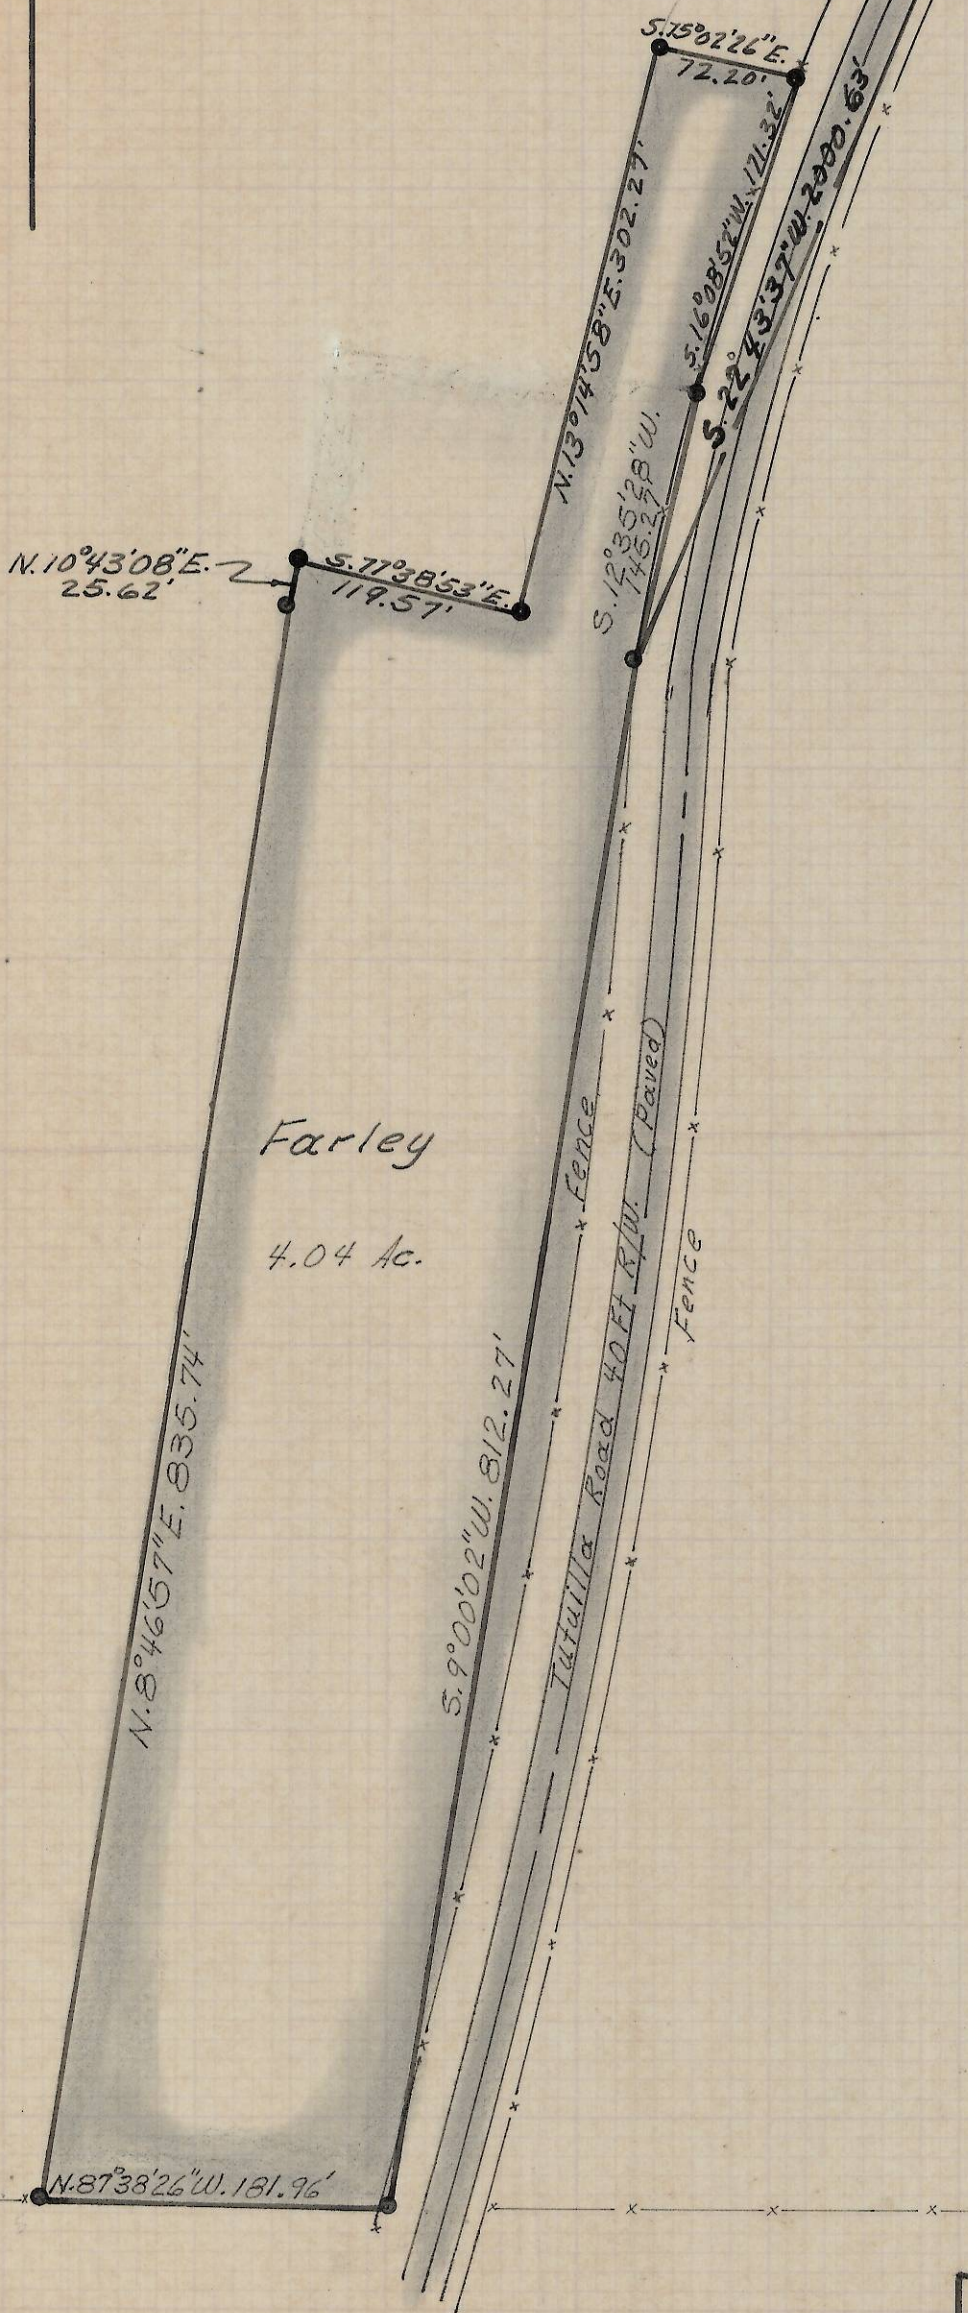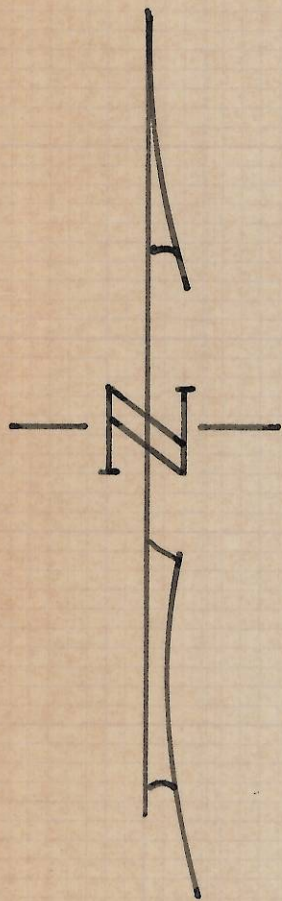

- ⊙ Mons. Found
- I.P.S. Found
- I.P.S. Set.

REGISTERED  
PROFESSIONAL  
LAND SURVEYOR

Ralph P. Thompson

OREGON  
MAY 23 1960  
RALPH P. THOMPSON  
508

Property Survey  
For  
**George Farley**  
As shown in Sec.22, T.2N.R32 E.

Date: 3-16-76 Scale: 1"=100'

RALPH THOMPSON

REGISTERED LAND SURVEYOR

P. O. BOX 1082 PENDLETON, ORE. 97801

L-67-A